MISSISSIPPI DEPARTMENT OF ENVIRONMENTAL QUALITY
Bureau of Land and Water Resources

P. O. Box 10631
Jackson, MS 39289-0631

WATER WELL DRILLERS LOG

COUNTY WELL LOCATED: Jackson	
WELL NUMBER: K9338	CODED:
PERMIT NUMBER:	
NAME OF DRILLING FIRM: Coast Water Well Co. Inc.	
DATE WELL COMPLETED: 11-8-91	

NAME & MAILING ADDRESS OF LANDOWNER
Keith Nichols
Hwy 57
Vandiver Ms.

WELL LOCATION: SEC 21 TOWNSHIP 6 N (S) RANGE 7 E (W)

DISTANCE: 1N Miles DIRECTION — NEAREST TOWN: Vandiver of

OTHER LANDMARK

WELL PURPOSE: Home, Irrigation, Municipal, Industrial, Fish Pond, etc.
office bldg.

PUMP DATA

PUMP TYPE (Circle One):
Submersible, Turbine, Jet, Flowing Well,
Other (Describe) _____

POWER TYPE (Circle One):
Electric, Tractor, Diesel, Gasoline, Butane,
Other (Describe) _____ H/P _____

Pump Capacity (GPM)	No. of Stages	Setting Depth
		FT.

PUMP TEST

Well yielded _____ GPM with
a drawdown of _____ ft.
after _____ hours of pumping

WELL DATA

Well Depth	Casing Diameter (In.)	Casing Length (Ft.)
107'	2"	97'
Type of Casing	**Hole Depth**	**Depth to Static Water Level**
PVC	107'	33'

TYPE OF COMPLETION: (Circle One or More):
Gravel Packed, Underreamed, Telescoped,
Natural Development, Open Hole, Other
(Describe) _____

Top of Lap Pipe or Reduction in Casing
FEET

IF TELESCOPED OR MORE THAN ONE SCREEN: USE BACK PAGE

LOG DATA

TYPE OF LOG RUN (Circle One): No Log Run
Electric, Gamma Ray, Density, Sonic, Neutron,
Other (Describe) _____

Name of Organization Running Log

GEOLOGIC DATA (Office Use Only)

Surface Elev.	Geologic Unit	Unit Thickness	Depth to Top
Subs. SWL	Date	Analysis	Aquifer Test

Driller's Remarks

RECEIVED
JAN 06 1992
Dept. of Environmental Quality
Bureau of Land & Water Resources

SCREEN DATA

Diameter - Inches	Length - Feet	Slot Size - Inches
2"	10'	.018
Screen Type	**Depth to Bottom - Feet**	
PVC	107'	

DESCRIPTION OF FORMATIONS ENCOUNTERED	FROM	TO	FORMATIONS (Continued)	FROM	TO
Top soil	0	2			
Red clay	2	21			
Red sand	21	45			
Blue clay	45	60			
Coarse sand	60	107			
			IF MORE SPACE IS NEEDED, USE BACK		

If well telescopes please sketch and show depths.

GROUND LEVEL

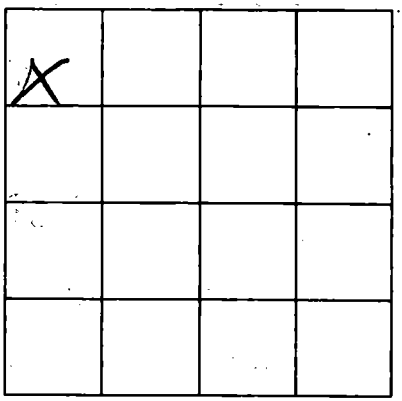

SECTION 21

Please indicate well location X.

ADDITIONAL INFORMATION

RECEIVED
JAN 06 1982
Dept. of Environmental Quality
Bureau of Land & Water Resources

If more than one screen, show location of each on sketch.