MISSISSIPPI DEPARTMENT OF ENVIRONMENTAL QUALITY
Bureau of Land and Water Resources

P. O. Box 10631
Jackson, MS 39289-0631
WATER WELL DRILLERS LOG

COUNTY WELL LOCATED: Jackson
WELL NUMBER: R2349 | CODED:
DATE WELL COMPLETED: 2-13-92

PERMIT NUMBER:
NAME OF DRILLING FIRM: Coast Water Well Ser. Inc.

NAME & MAILING ADDRESS OF LANDOWNER: Charlie Edmundson

WELL LOCATION: SEC 20 TOWNSHIP 6 (N/S) RANGE 7 (E/W)

DISTANCE: 2 Miles DIRECTION: South of NEAREST TOWN: Vancleave

OTHER LANDMARK:

WELL PURPOSE: Home, Irrigation, Municipal, Industrial, Fish Pond, etc.

PUMP DATA

PUMP TYPE (Circle One): Submersible, Turbine, (Jet) Flowing Well, Other (Describe) _____

POWER TYPE (Circle One): ~~Electric~~, Tractor, Diesel, Gasoline, Butane, ~~Other~~ (Describe) _____ H/P 1 hp

Pump Capacity (GPM)	No. of Stages	Setting Depth
		FT.

PUMP TEST

Well yielded _____ GPM with a drawdown of _____ ft. after _____ hours of pumping

WELL DATA

Well Depth	Casing Diameter (In.)	Casing Length (Ft.)
191'	2"	177'

Type of Casing	Hole Depth	Depth to Static Water Level
PVC	191'	50'

TYPE OF COMPLETION: (Circle One or More): Gravel Packed, Underreamed, Telescoped, Natural Development, Open Hole, Other (Describe) _____

Top of Lap Pipe or Reduction in Casing FEET

IF TELESCOPED OR MORE THAN ONE SCREEN: USE BACK PAGE

SCREEN DATA

Diameter - Inches	Length - Feet	Slot Size - Inches
2"	10'	.008

Screen Type	Depth to Bottom - Feet
PVC	187'

LOG DATA

TYPE OF LOG RUN (Circle One): (No Log Run), Electric, Gamma Ray, Density, Sonic, Neutron, Other (Describe) _____

Name of Organization Running Log:

GEOLOGIC DATA (Office Use Only)

Surface Elev.	Geologic Unit	Unit Thickness	Depth to Top
Subs. SWL	Date	Analysis	Aquifer Test

Driller's Remarks:

DESCRIPTION OF FORMATIONS ENCOUNTERED	FROM	TO
top soil	0	2
Yellow clay	2	25
Blue mud	25	50
fine sand	50	65
Gray Clay	65	75
Blue Clay	75	109
Coarse sand	109	187

FORMATIONS (Continued) | FROM | TO

RECEIVED
MAR 23 1992
Dept. of Environmental Quality
Bureau of Land & Water Resources

IF MORE SPACE IS NEEDED, USE BACK

If well telescopes please sketch and show depths.

GROUND LEVEL

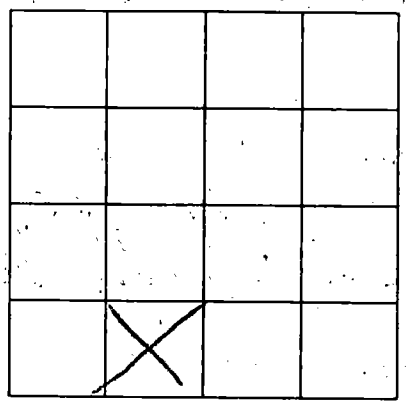

SECTION _____

Please indicate well location X.

ADDITIONAL INFORMATION

If more than one screen, show location of each on sketch.