MISSISSIPPI DEPARTMENT OF ENVIRONMENTAL QUALITY
Office of Land and Water Resources

P. O. Box 10631
Jackson, MS 39289-0631
WATER WELL DRILLERS LOG

COUNTY WELL LOCATED: Jackson
WELL NUMBER: K 2566 | CODED:
DATE WELL COMPLETED: 4-13-98

PERMIT NUMBER:
NAME OF DRILLING FIRM: Pierce Well

NAME & MAILING ADDRESS OF LANDOWNER: Kenny Roberts

Vancleave, Ms

WELL LOCATION — SEC: 13 TOWNSHIP: 6 N (S) RANGE: 7 E (W)

DISTANCE: 2 Miles DIRECTION: E of NEAREST TOWN: Vancleave

OTHER LANDMARK:

WELL PURPOSE: Home, Irrigation, Municipal, Industrial, Fish Pond, etc.

PUMP DATA

PUMP TYPE (Circle One): Submersible, Turbine, (Jet) Flowing Well, Other (Describe)

POWER TYPE (Circle One): (Electric) Tractor, Diesel, Gasoline, Butane, Other (Describe) H/P 1

Pump Capacity (GPM)	No. of Stages	Setting Depth
8	2	70 FT.

PUMP TEST

Well yielded 8 GPM with a drawdown of 10 ft. after 1 hours of pumping

WELL DATA

Well Depth	Casing Diameter (In.)	Casing Length (Ft.)
140'	2"	130

Type of Casing	Hole Depth	Depth to Static Water Level
Plastic	140'	60'

TYPE OF COMPLETION: (Circle One or More): Gravel Packed, Underreamed, Telescoped, (Natural Development), Open Hole, Other (Describe)

WELL GROUTED TO A DEPTH OF 15 FEET
Type Grout (circle one): Cement, Bentonite, or (Mix)

LOG DATA

TYPE OF LOG RUN (Circle One): (No Log Run), Electric, Gamma Ray, Density, Sonic, Neutron, Other (Describe)

Name of Organization Running Log

GEOLOGIC DATA (Office Use Only)

Surface Elev.	Geologic Unit	Unit Thickness	Depth to Top
Subs. SWL	Date	Analysis	Aquifer Test

Driller's Remarks

Top of Lap Pipe or Reduction in Casing: FEET — IF TELESCOPED OR MORE THAN ONE SCREEN: USE BACK PAGE

SCREEN DATA

Diameter - Inches	Length - Feet	Slot Size - Inches
2"	10	006

Screen Type	Depth to Bottom - Feet
Plastic	140'

DESCRIPTION OF FORMATIONS ENCOUNTERED	FROM	TO	FORMATIONS (Continued)	FROM	TO
Top Soil	0	10			
Sand & Clay	10	60			
Clay	60	100			
Sand	100	140			
			06-23-98A09:59	RCV	
			IF MORE SPACE IS NEEDED, USE BACK		

If well telescopes please
sketch and show depths.

GROUND LEVEL

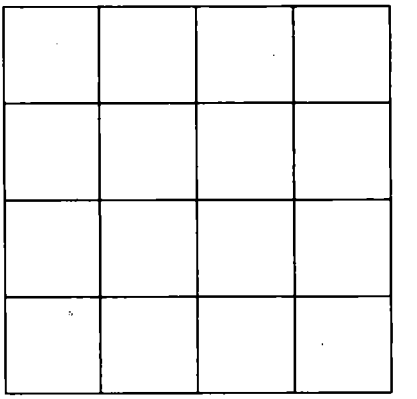

SECTION _____

Please indicate well location X.

ADDITIONAL INFORMATION

If more than one screen,
show location of each on sketch.