MISSISSIPPI DEPARTMENT OF ENVIRONMENTAL QUALITY
Office of Land and Water Resources

P. O. Box 10631
Jackson, MS 39289-0631
WATER WELL DRILLERS LOG

COUNTY WELL LOCATED: Jackson	
WELL NUMBER: K 2617	CODED:
PERMIT NUMBER:	
NAME OF DRILLING FIRM: Coast Water Well Service	
DATE WELL COMPLETED: 6-1-99	

NAME & MAILING ADDRESS OF LANDOWNER: Alex Bertagnolli, Bluff Ridge Dr., Vancleave Ms

WELL LOCATION	SEC	TOWNSHIP	RANGE
	21	6 N/S	7 E/W

DISTANCE	DIRECTION	NEAREST TOWN
1/2 Miles	South of	Vancleave

OTHER LANDMARK:

WELL PURPOSE (Home, Irrigation, Municipal, Industrial, Fish Pond, etc.): Home

PUMP DATA

PUMP TYPE (Circle One): Submersible, Turbine, Jet, Flowing Well, Other (Describe) _____

POWER TYPE (Circle One): Electric, Tractor, Diesel, Gasoline, Butane, Other (Describe) _____ H/P 1

Pump Capacity (GPM)	No of Stages	Setting Depth
7.5	2	FT.

PUMP TEST

Well yielded _____ GPM with a drawdown of _____ ft. after _____ hours of pumping

WELL DATA

Well Depth	Casing Diameter (In.)	Casing Length (Ft.)
285'	2"	275'
Type of Casing	**Hole Depth**	**Depth to Static Water Level**
PVC	285'	50'

TYPE OF COMPLETION: (Circle One or More): Gravel Packed, Underreamed, Telescoped, Natural Development, Open Hole, Other (Describe) _____

WELL GROUTED TO A DEPTH OF 20 FEET
Type Grout (circle one): Cement, Bentonite or Mix

LOG DATA

TYPE OF LOG RUN (Circle One): Electric, Gamma Ray, Density, Sonic, Neutron, No Log Run, Other (Describe) _____

Name of Organization Running Log:

SCREEN DATA

Diameter - Inches	Length - Feet	Slot Size - Inches
2"	10'	.008
Screen Type	**Depth to Bottom - Feet**	
PVC	285'	

GEOLOGIC DATA (Office Use Only)

Surface Elev	Geologic Unit	Unit Thickness	Depth to Top
Subs. SWL	Date	Analysis	Aquifer Test

Driller's Remarks:

Top of Lap Pipe or Reduction in Casing: FEET

IF TELESCOPED OR MORE THAN ONE SCREEN: USE BACK PAGE

DESCRIPTION OF FORMATIONS ENCOUNTERED	FROM	TO
Top Soil	0	2
White Coarse Sand	2	14
White Clay	14	30
White Coarse Sand	30	125
Blue Clay Sh-Sand	125	268
Gray Coarse Sand	268	285

FORMATIONS (Continued)	FROM	TO

IF MORE SPACE IS NEEDED, USE BACK

RECEIVED
JUL 09 1999
Dept. of Environmental Quality
Office of Land & Water Resource

If well telescopes please sketch and show depths.

GROUND LEVEL

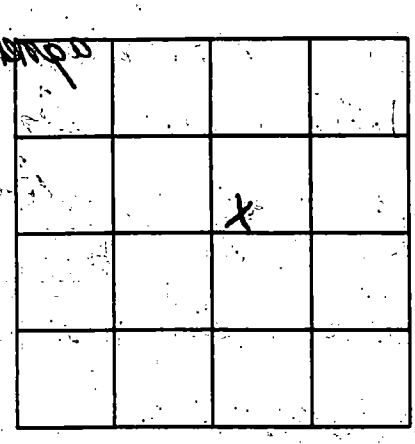

SECTION 21

Please indicate well location X.

ADDITIONAL INFORMATION

RECEIVED
JUL 03 1989
Dept. of Environmental Quality
Office of Land & Water Resources

If more than one screen, show location of each on sketch.