JACKSON
L 96
3-22-72

MISSISSIPPI
BOARD OF WATER COMMISSIONERS
416 North State Street
Jackson, Mississippi 39201

CODED

WATER WELL DRILLERS LOG

Mar 22 1972 Colville Water Sup. Jackson
date well completed — firm name — county well located

LANDOWNER: Pat Dugan
Escatawpa Ms
(mailing address)

WELL LOCATION:
sec. 35 T 6 N (S) R 6 E (W)
7 miles North of M.P.
(distance) (direction) (nearest town)

WELL PURPOSE: home
(home, irrigation, municipal, industrial)

WELL COMPLETION DATA:

(1) diameter (inches) 2
(2) total depth (feet) 360
(3) static water level (feet) 13-4 below above top of ground.
(4) casing galv (material), 355 (depth),
(size) If telescope see back.
(5) screen 5' (length), 355 (depth to top)
2" (size), Stainless (material)
(6) pump (HP) (yield gpm)
(type power)
(7) electric log NO (yes or no)
(organization running log)
(8) how well bottom plugged BP Valve

DRILLERS REMARKS: Pump installed by owner

description of formations encountered	from	to
Fill	0	6
Clay	6	90
Sand & Gule	90	160
Clay	160	338
Sand	338	360

CODED

MAY 24 1972
MISS. BD. OF WATER COMM.

If well telescopes please sketch and show depths.

GROUND LEVEL

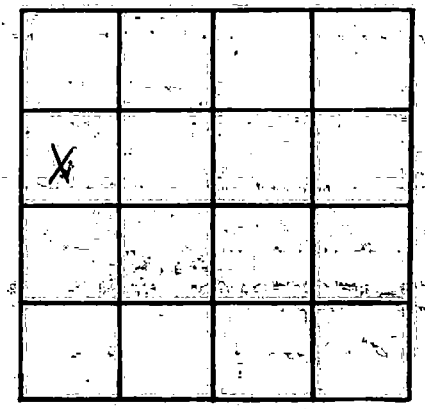

SECTION 35

Please indicate well location X.

ADDITIONAL INFORMATION

If more than one screen, show locations of each on sketch.