JACKSON
L 7001
2/16/77

13a

MISSISSIPPI
BOARD OF WATER COMMISSIONERS
416 North State Street
Jackson, Mississippi 39201

WATER WELL DRILLERS LOG

2-16 1977 COAST WATER WELL SERVICE Jackson
date well completed — firm name — county well located

LANDOWNER: Willie Mae Moloc
Rt 5 Box 378
Pascagoula, Miss 39567
(mailing address)

WELL LOCATION:
sec. 11 T 6 ~~N~~ (S) R 6 ~~E~~ (W)
7 miles N. of Moss Point
(distance) (direction) (nearest town)

WELL PURPOSE: home
(home, irrigation, municipal, industrial)

WELL COMPLETION DATA:
(1) diameter (inches) 2
(2) total depth (feet) 316
(3) static water level (feet) 20 (below) ~~above~~ top of ground.
(4) casing PVC (material), 306 (depth), 2 (size) If telescope see back.
(5) screen 10 (length), 306 (depth to top), 2 (size), PVC (material)
(6) pump — (HP) — (yield gpm)
Elect (type power)
(7) electric log No (yes or no)
— (organization running log)
(8) how well bottom plugged Pack wash Value

DRILLERS REMARKS:

description of formations encountered	from	to
top soil	0	2
grey clay	2	22
Sand + gravel	22	97
blue clay	97	274
Med. Sand	274	290
blue clay	290	292
Sand Med to Coarse	292	316

RECEIVED
MAR - 9 1977
MISS. BD. OF WATER COMM

If well telescopes please sketch and show depths.

GROUND LEVEL

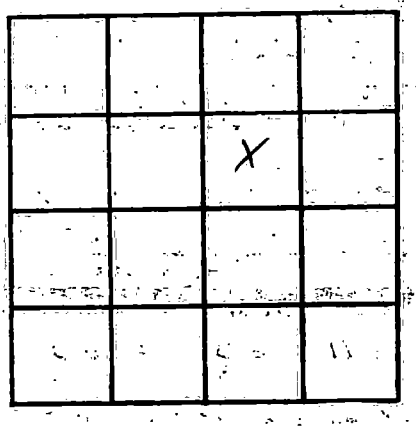

SECTION 11

Please indicate well location X.

ADDITIONAL INFORMATION

If more than one screen, show locations of each on sketch.