MISSISSIPPI DEPARTMENT OF ENVIRONMENTAL QUALITY
Office of Land and Water Resources

P. O. Box 10631
Jackson, MS 39289-0631

WATER WELL DRILLERS LOG

COUNTY WELL LOCATED: Jackson
WELL NUMBER: L 2092 | CODED:
DATE WELL COMPLETED: 8-10-95

PERMIT NUMBER:
NAME OF DRILLING FIRM: Pierce

NAME & MAILING ADDRESS OF LANDOWNER: Mark Mitchell
Gautier, MS

WELL LOCATION — SEC: 36 TOWNSHIP: 6 N (S) RANGE: 6 E (W)

DISTANCE: 3 Miles DIRECTION: N of NEAREST TOWN: I-10

OTHER LANDMARK:

WELL PURPOSE (Home, Irrigation, Municipal, Industrial, Fish Pond, etc.): Home

PUMP DATA

PUMP TYPE (Circle One): Submersible, Turbine, (Jet), Flowing Well, Other (Describe)

POWER TYPE (Circle One): (Electric), Tractor, Diesel, Gasoline, Butane, Other (Describe) H/P 1

Pump Capacity (GPM)	No of Stages	Setting Depth
10	2	60 FT.

PUMP TEST

Well yielded 10 GPM with a drawdown of 10 ft. after 1 hours of pumping

WELL DATA

Well Depth	Casing Diameter (In.)	Casing Length (Ft.)
230	2"	220

Type of Casing	Hole Depth	Depth to Static Water Level
Plastic	230	30

TYPE OF COMPLETION: (Circle One or More): Gravel Packed, Underreamed, Telescoped, Natural Development, Open Hole, Other (Describe)

WELL GROUTED TO A DEPTH OF 12 FEET
Type Grout (circle one): (Cement), Bentonite, or Mix

LOG DATA

TYPE OF LOG RUN (Circle One): (No Log Run), Electric, Gamma Ray, Density, Sonic, Neutron, Other (Describe)

Name of Organization Running Log

GEOLOGIC DATA (Office Use Only)

Surface Elev.	Geologic Unit	Unit Thickness	Depth to Top
Subs. SWL	Date	Analysis	Aquifer Test

Driller's Remarks

SCREEN DATA

Diameter - Inches	Length - Feet	Slot Size - Inches
2"	10	006

Screen Type	Depth to Bottom - Feet
Plastic	230

Top of Lap Pipe or Reduction in Casing: FEET

IF TELESCOPED OR MORE THAN ONE SCREEN: USE BACK PAGE

RECEIVED
SEP 07 1995
Dept. of Environmental Quality
Office of Land & Water Resources

DESCRIPTION OF FORMATIONS ENCOUNTERED	FROM	TO
top soil	0	10
Clay	10	20
Sand	20	40
Clay	40	100
Sand	100	160
Clay	160	200
good sand	200	230

FORMATIONS (Continued)	FROM	TO

IF MORE SPACE IS NEEDED, USE BACK

If well telescopes please
sketch and show depths.

GROUND LEVEL

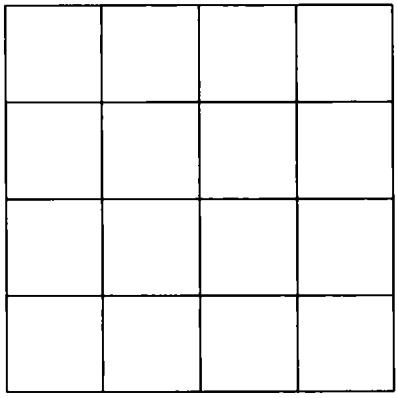

SECTION _____

Please indicate well location X.

ADDITIONAL INFORMATION

If more than one screen,
show location of each on sketch.