MISSISSIPPI DEPARTMENT OF ENVIRONMENTAL QUALITY
Bureau of Land and Water Resources

P. O. Box 10631
Jackson, MS 39289-0631
WATER WELL DRILLERS LOG

COUNTY WELL LOCATED: Jackson	
WELL NUMBER: MW 13	CODED:
L-2137	PERMIT NUMBER:
DATE WELL COMPLETED: 3/22/02	NAME OF DRILLING FIRM: PSI WWC 0578 Professional Service Ind.

NAME & MAILING ADDRESS OF LANDOWNER
Macland Ash Disposal
11300 Hwy 63
Moss point MS 39563

WELL LOCATION: SEC 25 TOWNSHIP 6 N (S) RANGE 6 E (W)

DISTANCE 2 Miles DIRECTION NORTH of NEAREST TOWN Moss point

OTHER LANDMARK
N30°30' 15.6" W88°32' 05.8"

WELL PURPOSE: Home, Irrigation, Municipal, Industrial, Fish Pond, etc.
Monitoring (Industrial)

PUMP DATA

PUMP TYPE (Circle One):
Submersible, Turbine, Jet Flowing Well,
Other (Describe) _____

POWER TYPE (Circle One):
Electric, Tractor, Diesel, Gasoline, Butane,
Other (Describe) _____ H/P _____

Pump Capacity (GPM)	No. of Stages	Setting Depth
		FT.

PUMP TEST
Well yielded _____ GPM with
a drawdown of _____ ft.
after _____ hours of pumping

WELL DATA

Well Depth	Casing Diameter (In.)	Casing Length (Ft.)
50'	2"	47.5

Type of Casing	Hole Depth	Depth to Static Water Level
PVC	50'	surface

TYPE OF COMPLETION: (Circle One or More):
Gravel Packed, Underreamed, Telescoped,
Natural Development, Open Hole, Other
(Describe) Sand Filter

Top of Lap Pipe or Reduction in Casing
FEET — IF TELESCOPED OR MORE THAN ONE SCREEN: USE BACK PAGE

LOG DATA

TYPE OF LOG RUN (Circle One): No Log Run,
Electric, Gamma Ray, Density, Sonic, Neutron,
Other (Describe) _____

Name of Organization Running Log

GEOLOGIC DATA (Office Use Only)

Surface Elev.	Geologic Unit	Unit Thickness	Depth to Top
Subs. SWL	Date	Analysis	Aquifer Test

Driller's Remarks

SCREEN DATA

Diameter - Inches	Length - Feet	Slot Size - Inches
2"	5'	.010

Screen Type	Depth to Bottom - Feet
PVC	50'

DESCRIPTION OF FORMATIONS ENCOUNTERED	FROM	TO
gr lbr/bl org si	0	3
gr/or/red sa cl	3	15
gr si cl w/ trr sa	15	42
gr sa	42	50

FORMATIONS (Continued)	FROM	TO

RECEIVED
APR 15 2002
BY: OLWR

IF MORE SPACE IS NEEDED, USE BACK

If well telescopes please
sketch and show depths.

GROUND LEVEL

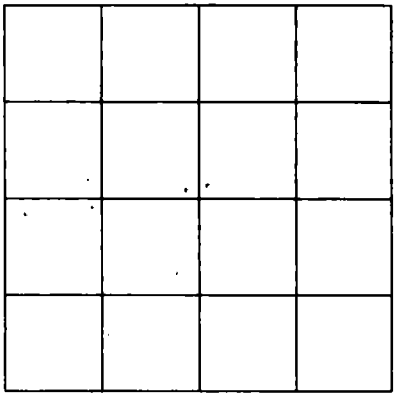

SECTION _____

Please indicate well location X.

ADDITIONAL INFORMATION

If more than one screen,
show location of each on sketch.