Jackson
M 133
2-2068

MISSISSIPPI
BOARD OF WATER COMMISSIONERS
416 North State Street
Jackson, Mississippi 39201

COUED
CODED

WATER WELL DRILLERS LOG

Feb 20 1968 Cobville Water Dep Jackson
date well completed — firm name — county well located

LANDOWNER: ~~Leo Linder~~
Leo Linder
Orange Grove
(mailing address)

WELL LOCATION:
sec 32 T 6 N (S) R 4 E (W)
6½ miles NE of MP
(distance) (direction) (nearest town)

WELL PURPOSE: home
(home, irrigation, municipal, industrial)

WELL COMPLETION DATA:

(1) diameter (inches) 2
(2) total depth (feet) 374
(3) static water level (feet) 19 below above top of ground
(4) casing galv (material), (depth),
(size) if telescope see back.
(5) screen 4' (length), 370 (depth to top)
2 (size), ~~Stainless~~ (material)
(6) pump no pump (HP) (yield gpm)
(type power)
(7) electric log no (yes or no)
(organization running log)
(8) how well bottom plugged BP Valve

DRILLERS REMARKS:

description of formations encountered	from	to
clay	0	4
sand	8	72
clay	72	85
sand	85	156
clay	156	176
sand	176	194
clay	194	337
sand	337	374

If well telescopes please sketch and show depths.

GROUND LEVEL

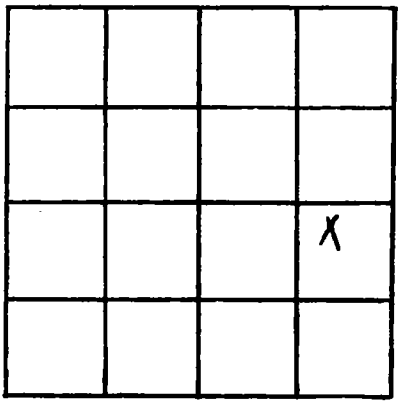

SECTION 32

Please indicate well location X.

ADDITIONAL INFORMATION

If more than one screen, show locations of each on sketch.