JACKSON
M172
1-31-72

CODED

MISSISSIPPI
BOARD OF WATER COMMISSIONERS
416 North State Street
Jackson, Mississippi 39201

MAR 22 1972

WATER WELL DRILLERS LOG

1-31 1972 Coast Water Well Co. Jackson
date well completed — firm name — county well located

LANDOWNER: W. R. Perkins
Rt-1
Pascagoula, Miss.
(mailing address)

WELL LOCATION:
sec. 31 T. 6 N S R 4 E W
8 miles N-E of Moss Point
(distance) (direction) (nearest town)

WELL PURPOSE: house
(home, irrigation, municipal, industrial)

WELL COMPLETION DATA:

(1) diameter (inches) 2"
(2) total depth (feet) 145
(3) static water level (feet) 3 below ~~above~~ top of ground.
(4) casing PVC (material), 140' (depth),
2" (size) If telescope see back.
(5) screen 5' (length), 140' (depth to top)
2" (size), all stainless (material)
(6) pump 1/2 (HP) 9 (yield gpm)
elec (type power)
(7) electric log elec (yes or no)
(organization running log)
(8) how well bottom plugged back-wash valve

DRILLERS REMARKS:

description of formations encountered	from	to
top soil	0	5
sand - fine to coarse	5	145

CODED

If well telescopes please sketch and show depths.

GROUND LEVEL

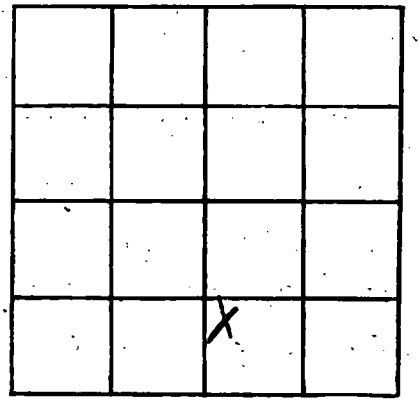

SECTION 31

Please indicate well location X.

ADDITIONAL INFORMATION

If more than one screen, show locations of each on sketch.