JACKSON
M 174
2-21-72

CODED

MISSISSIPPI
BOARD OF WATER COMMISSIONERS
416 North State Street
Jackson, Mississippi 39201

WATER WELL DRILLERS LOG

Feb 21 1972 Colville Water Supply Jackson
date well completed — firm name — county well located

LANDOWNER: Joe Drake
Lotus St. Helena
(mailing address)

WELL LOCATION:
sec. 31 T 6 N R 5 E

6 miles NE of MP
(distance) (direction) (nearest town)

WELL PURPOSE: home
(home, irrigation, municipal, industrial)

WELL COMPLETION DATA:

(1) diameter (inches) 2

(2) total depth (feet) 153

(3) static water level (feet) 1 below/above top of ground.

(4) casing SPIV (material), 148 (depth),
(size) if telescope see back.

(5) screen 51 (length), 148 (depth to top)
2" (size), galv (material)

(6) pump (HP) (yield gpm)
(type power)

(7) electric log No (yes or no)
(organization running log)

(8) how well bottom plugged BP Valve

DRILLERS REMARKS: Pump installed by owner

description of formations encountered	from	to
clay	0	21
sand	21	55
clay	55	140
sand	140	153

CODED

MAY 24 1972
MISS. BD. OF
WATER COMMS

If well telescopes please sketch and show depths.

GROUND LEVEL

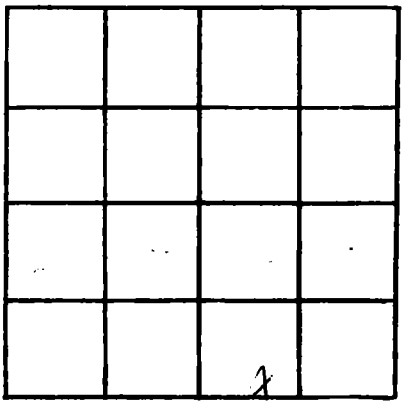

SECTION 34

Please indicate well location X.

ADDITIONAL INFORMATION

If more than one screen, show locations of each on sketch.