JACKSON
M#187
7-13-72

MISSISSIPPI
BOARD OF WATER COMMISSIONERS
416 North State Street
Jackson, Mississippi 39201

CODED

WATER WELL DRILLERS LOG

July 13 1972 Coleville Well Co. Jackson
date well completed — firm name — county well located

LANDOWNER: Larry Young
2 Sub. 2
Helena Miss.
(mailing address)

WELL LOCATION:
sec. 11 T 6 N (S) R 5 E (W)
8 miles NE of Moss Point
(distance) (direction) (nearest town)

WELL PURPOSE: home
(home, irrigation, municipal, industrial)

WELL COMPLETION DATA:
(1) diameter (inches) 2"
(2) total depth (feet) 69
(3) static water level (feet) +5 below above top of ground.
(4) casing galv, 69,
(material) (depth)
(size) If telescope see back.
(5) screen stainless, 63
(length) (depth to top)
2" stainless
(size) (material)
(6) pump 1/2 6
(HP) (yield gpm)
elec
(type power)
(7) electric log No
(yes or no)
(organization running log)
(8) how well bottom plugged R.P. Wilson

DRILLERS REMARKS:

description of formations encountered	from	to
Clay	0	15
Sand	15	20
Soft Blue Clay	20	27
Sand	27	69

CODED

If well telescopes please sketch and show depths.

GROUND LEVEL

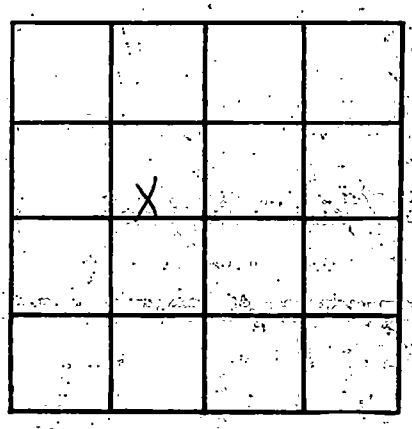

SECTION 16

Please indicate well location X.

ADDITIONAL INFORMATION

If more than one screen, show locations of each on sketch.