JACKSON
M 206
1-27-73

MISSISSIPPI
BOARD OF WATER COMMISSIONERS
416 North State Street
Jackson, Mississippi 39201

CODED

WATER WELL DRILLERS LOG

1/27 (date well completed) 19 73 Coast Water well Service (firm name) Jackson (county well located)

LANDOWNER: James A. Jones
Rt. 3 Box 241
Pascagoula, Mo. 39567
(mailing address)

WELL LOCATION:
sec. 10 T 6 S R 5 W
9 (distance) miles N (direction) of Moss Point (nearest town)

WELL PURPOSE: Home
(home, irrigation, municipal, industrial)

WELL COMPLETION DATA:

(1) diameter (inches) 2"
(2) total depth (feet) 199'
(3) static water level (feet) 20' below above top of ground.
(4) casing galv. (material), 189' (depth), 2" (size) if telescope see back.
(5) screen 10' (length), 189' (depth to top), 2" (size), stainless steel (material)
(6) pump 1/2 (HP) 9 (yield gpm) electric (type power)
(7) electric log No (yes or no)
(organization running log)
(8) how well bottom plugged backwash valve

DRILLERS REMARKS:

description of formations encountered	from	to
Top Soil	0	31
Blue Clay to Fine Sand	31	52
Fine Sand	52	73
Fine Sand and Gravel	73	94
Med. Sand	94	115
Med Sand to Blue Clay	115	136
Coarse Sand	136	199

CODED

JAN 25 1973

If well telescopes please sketch and show depths.

GROUND LEVEL

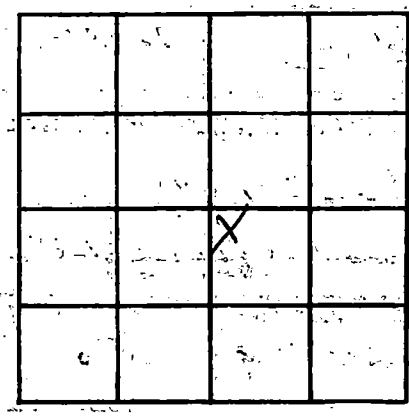

SECTION 10

Please indicate well location X.

ADDITIONAL INFORMATION

If more than one screen, show locations of each on sketch.