JACKSON
M216
10-12-73

CODED

MISSISSIPPI
BOARD OF WATER COMMISSIONERS
416 North State Street
Jackson, Mississippi 39201

WATER WELL DRILLERS LOG

Oct 12 1973 Colville Water Supply Jackson
date well completed — firm name — county well located

LANDOWNER: R. W. Shattles
Wade MS
(mailing address)

WELL LOCATION:
sec. 19 T 6 N (S) R 5 E (W)
3 miles East of Wade
(distance) (direction) (nearest town)

WELL PURPOSE: home
(home, irrigation, municipal, industrial)

WELL COMPLETION DATA:

(1) diameter (inches) 2
(2) total depth (feet) 315
(3) static water level (feet) 16-6 below above top of ground.
(4) casing galv (material), 305 (depth),
_____ (size) if telescope see back.
(5) screen 10' (length), 305 (depth to top)
2" (size), stainless (material)
(6) pump 1½ (HP) 20 (yield gpm)
elec (type power)
(7) electric log no (yes or no)
_____ (organization running log)
(8) how well bottom plugged BP Wells

DRILLERS REMARKS:

description of formations encountered	from	to
Clay	0	12
sand	12	15
clay	15	32
sand	32	70
clay	70	305
CODED		

DEC 21 1973

If well telescopes please sketch and show depths.

GROUND LEVEL

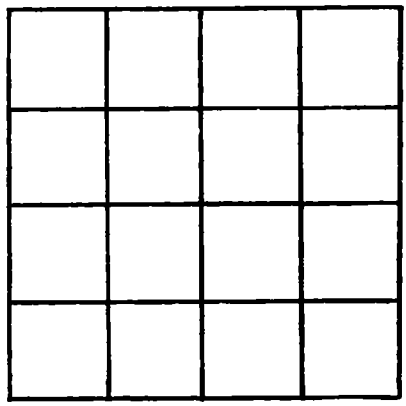

SECTION _____

Please indicate well location X.

ADDITIONAL INFORMATION

If more than one screen, show locations of each on sketch.