JACKSON
M239

MISSISSIPPI DEPARTMENT OF NATURAL RESOURCES
Bureau of Land and Water Resources
Southport Mall
P.O. Box 10631
Jackson, Mississippi 39209

CODED

WATER WELL DRILLERS LOG

6-27 1984 — date well completed
Coast Water Well Serv. — firm name
Jackson — county well located

LANDOWNER: John Marie
9313 Franklin Creek Rd.
Pascagoula Miss.
(mailing address) 39567

WELL LOCATION:
sec. 31 T 6 N/S R 4 E/W
5 (distance) miles NE (direction) of Moss Point (nearest town)

WELL PURPOSE:
(home, irrigation, municipal, industrial)

WELL COMPLETION DATA:
(1) diameter (inches) 2"
(2) total depth (feet) 435'
(3) static water level (feet) 12' below / above top of ground.
(4) casing PVC (material), 425' (depth), 2" (size) if telescope see back.
(5) screen 10' (length), 425' (depth to top), 2" (size), PVC (material)
(6) pump — (HP) — (yield gpm)
— (type power)
(7) electric log — (yes or no)
— (organization running log)
(8) how well bottom plugged Backwash valve

DRILLERS REMARKS:

description of formations encountered	from	to
Red Clay	0'	15'
Blue Clay	15'	105'
Blue Clay & strip of Sand	105'	120'
Coarse Sand	120'	165'
Blue Clay	165'	223'
Blue Clay & Streak of Sand	223'	270'
Blue Clay	270'	330'
Fine Sand	330'	360'
Coarse Sand	360'	435'

DEPT. OF NATURAL RESOURCES
BUREAU OF LAND & WATER RESOURCES
JUL 10 1984
RECEIVED

If well telescopes please sketch and show depths.

GROUND LEVEL

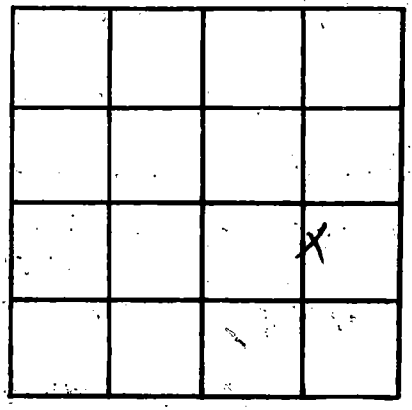

SECTION 31

Please indicate well location X.

ADDITIONAL INFORMATION

If more than one screen, show locations of each on sketch.