MISSISSIPPI DEPARTMENT OF ENVIRONMENTAL QUALITY
Office of Land and Water Resources

P. O. Box 10631
Jackson, MS 39289-0631
WATER WELL DRILLERS LOG

COUNTY WELL LOCATED	
Jackson	
WELL NUMBER	CODED
N- 397	
DATE WELL COMPLETED	
12-22-03	

PERMIT NUMBER
NAME OF DRILLING FIRM
Coast Water Well Service

NAME & MAILING ADDRESS OF LANDOWNER
John Schollian
Lily Orchard
Latitude:
Longitude: Moss Point, MS

WELL LOCATION	SEC	TOWNSHIP	RANGE
	11	6 N (S)	5 E (W)

DISTANCE	DIRECTION	NEAREST TOWN
3 1/2 Miles	NE	of Helena

OTHER LANDMARK

WELL PURPOSE: (Home), Irrigation, Municipal, Industrial, Fish Pond, etc.

WELL DATA

Well Depth	Casing Diameter (In.)	Casing Length (Ft.)
175'	2"	165'
Type of Casing	**Hole Depth**	**Depth to Static Water Level**
PVC	175'	10'

TYPE OF COMPLETION: (Circle One or More):
Gravel Packed, Underreamed, Telescoped, (Natural Development), Open Hole, Other (Describe) _____

WELL GROUTED TO A DEPTH OF 10 FEET
Type Grout (circle one): Cement, (Bentonite) or Mix

SCREEN DATA

Diameter - Inches	Length - Feet	Slot Size - Inches
2"	10'	.008
Screen Type		**Depth to Bottom - Feet**
PVC		175'

PUMP DATA

PUMP TYPE (Circle One):
Submersible, Turbine, (Jet) Flowing Well,
Other (Describe) _____

POWER TYPE (Circle One):
(Electric), Tractor, Diesel, Gasoline, Butane,
Other (Describe) _____ H/P 1/2

DESCRIPTION OF FORMATIONS ENCOUNTERED	FROM	TO
Top Soil	0	2
Orange Clay	2	10
White Coarse Sand	10	39
Blue Clay w/str. of Sand	39	150
Grey Coarse Sand	150	175

RECEIVED
DEC 29 2003
BY: OLWR

Top of Lap Pipe or Reduction in Casing
FEET
IF TELESCOPED OR MORE THAN ONE SCREEN: USE BACK PAGE

I certify that the well was drilled, constructed and completed in accordance with all applicable Requirements of the Mississippi Department of Environmental Quality and/or the Mississippi Department of Health regulations and state laws.

Jack Ridgdale 972
Signature of Licensed Driller and License No.

12/23/03
Date

Additional Information Required On Back

If well telescopes please sketch and show depths.

GROUND LEVEL

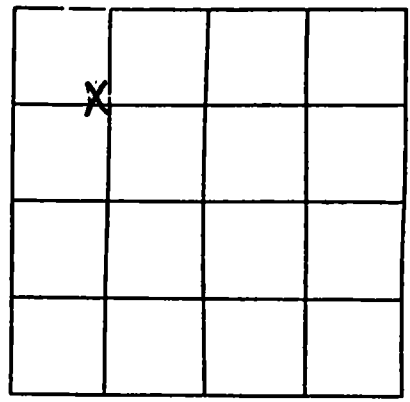

SECTION 11

Please indicate well location X.

Pump Capacity (GPM)	No. of Stages	Setting Depth
6.5	1	FT.

PUMP TEST

Well yielded _____ GPM with

a drawdown of _____ ft.

after _____ hours of pumping

LOG DATA

TYPE OF LOG RUN (Circle One): No Log Run. Electric. Gamma Ray. Density. Sonic. Neutron. Other (Describe) _____

Name of Organization Running Log

GEOLOGIC DATA (Office Use Only)

Surface Elev.	Geologic Unit	Unit Thickness	Depth to Top
Subs. SWL	Date	Analysis	Aquifer Test

Driller's Remarks

If more than one screen, show location of each on sketch.