JACKSON

M 2039

8-25-78

MISSISSIPPI
BOARD OF WATER COMMISSIONERS
416 North State Street
Jackson, Mississippi 39201

WATER WELL DRILLERS LOG

8-25 1978 Coast Water Well Ser Inc- Jackson
date well completed — firm name — county well located

LANDOWNER: Billy Starks
Rt 1- Box 484
Pascagoula Miss 39567
(mailing address)

WELL LOCATION:
sec. 6 T. 6 (S) R. 4 (W)
8 miles N. East of Moss Point
(distance) (direction) (nearest town)

WELL PURPOSE: home
(home, irrigation, municipal, industrial)

WELL COMPLETION DATA:
(1) diameter (inches) 2"
(2) total depth (feet) 305'
(3) static water level (feet) 5' below above top of ground
(4) casing P.V.C. (material), 295' (depth), 2" (size) If telescope see back.
(5) screen 10' (length), 295' (depth to top), 2" (size), P.V.C. (material)
(6) pump 1/2 h.p. (HP) 7 (yield gpm)
Elect. (type power)
(7) electric log no (yes or no)
(organization running log)
(8) how well bottom plugged Back Wash Valve

DRILLERS REMARKS:

description of formations encountered	from	to
Top soil	0	4
Red Coarse sand + gravel	4	70
Red Clay	70	82
Red Coarse sand	82	135
Blue Clay	135	137
Red Coarse sand	137	150
Blue Clay	150	207
Gray Coarse sand + gravel	207	305

RECEIVED
NOV - 9 1978
MISS. BD. OF WATER COMM

If well telescopes please sketch and show depths.

GROUND LEVEL

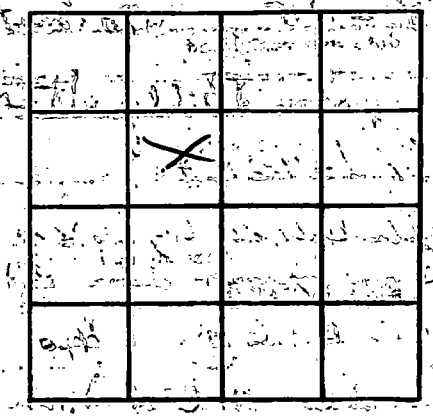

SECTION 6

Please indicate well location X.

ADDITIONAL INFORMATION

If more than one screen, show locations of each on sketch.