Jackson
M 7045
12-21-78

MISSISSIPPI
BOARD OF WATER COMMISSIONERS
416 North State Street
Jackson, Mississippi 39201

WATER WELL DRILLERS LOG

12-21- 1978 Coast Water Wells Inc Jackson
date well completed — firm name — county well located

LANDOWNER: Lenny Wildman
Box 219, RR 3
Pascagoula Miss 39567
(mailing address)

WELL LOCATION:
sec 11 T 6 (S) R 5 (W)
7 miles North of Moss Point
(distance) (direction) (nearest town)

WELL PURPOSE: Home
(home, irrigation, municipal, industrial)

WELL COMPLETION DATA:
(1) diameter (inches) 2"
(2) total depth (feet) 208'
(3) static water level (feet) 15-1 below / above top of ground.
(4) casing PVC (material), 198' (depth),
2" (size) if telescope see back.
(5) screen 10' (length), 198' (depth to top)
2" (size), PVC (material)
(6) pump 1/2 h.p. (HP) 7- (yield gpm)
Elect. (type power)
(7) electric log No (yes or no)
(organization running log)
(8) how well bottom plugged Jack Wash Valve

DRILLERS REMARKS:

description of formations encountered	from	to
Top soil	0	4
Gray Clay	4	21
Sand Cmc	21	32
Gray Clay	32	55
Sand-Gravel	55	110
Blue Clay	110	135
Sand Cmc	135	168
Blue Clay	168	180
Sand Cmc	180	208

Miss. Board of Water Commissioners
MAY 29 1979
RECEIVED

If well telescopes please sketch and show depths.

GROUND LEVEL

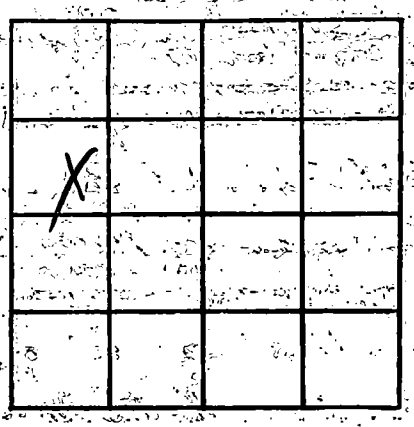

SECTION 11

Please indicate well location X.

ADDITIONAL INFORMATION

If more than one screen, show locations of each on sketch.