Jackson
M 2077

10-14-80

MISSISSIPPI
BOARD OF WATER COMMISSIONERS
416 North State Street
Jackson, Mississippi 39201

WATER WELL DRILLERS LOG

10-14- 1980 — date well completed
Coast Water Well Service — firm name
Jackson — county well located

LANDOWNER: Ed. Taylor
P.O. Box 597
Escatawpa Miss. 39352
(mailing address)

WELL LOCATION:
sec. 30 T. 6 (S) R. 5 (W)
4 miles (distance) NNE (direction) of ESCATAWPA (nearest town)

WELL PURPOSE: Home
(home, irrigation, municipal, industrial)

WELL COMPLETION DATA:

(1) diameter (inches) 2"
(2) total depth (feet) 145'
(3) static water level (feet) 10' below / above top of ground.
(4) casing PVC (material), 135' (depth), 2" (size) if telescope see back.
(5) screen 10' (length), 135' (depth to top), 2" (size), PVC (material)
(6) pump 1 h.p. (HP), 9 (yield gpm), Elect. (type power)
(7) electric log No. (yes or no)
N/A. (organization running log)
(8) how well bottom plugged Check Valve

DRILLERS REMARKS:

description of formations encountered	from	to
Top soil	0	2'
Gray Clay	2'	55'
Coarse sand	55'	70'
Blue Clay	70'	115'
Coarse sand	115'	145'

DEPT. OF NATURAL RESOURCES
BUREAU OF LAND & WATER RESOURCES
APR -6 1981
RECEIVED

If well telescopes please sketch and show depths.

GROUND LEVEL

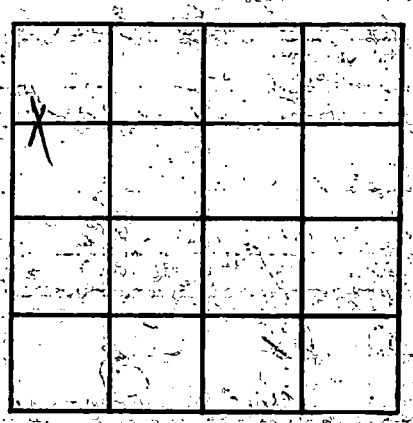

SECTION 30

Please indicate well location X.

ADDITIONAL INFORMATION

If more than one screen, show locations of each on sketch.