MISSISSIPPI DEPARTMENT OF NATURAL RESOURCES

Bureau of Land and Water Resources

P.O. Box 10631
Jackson, Mississippi 39209

WATER WELL DRILLERS LOG

COUNTY WELL LOCATED	Jackson
WELL NUMBER	M 217
CODED	
DATE WELL COMPLETED	10-27-86
PERMIT NUMBER	
NAME OF DRILLING FIRM	Good Water well

NAME & MAILING ADDRESS OF LANDOWNER: Ron Craig & Jesse Sturgis, 13832 Wolfridge Rd, Pascagoula MS

WELL LOCATION: SEC 7 TOWNSHIP 6 S RANGE 5 W

DISTANCE 4 Miles DIRECTION SE of NEAREST TOWN Helena

OTHER LANDMARK:

WELL PURPOSE: Home, Irrigation, Municipal, Industrial, Fish Pond, etc.: home

PUMP DATA

PUMP TYPE (Circle One): Submersible, Turbine, (Jet), Flowing Well, Other (Describe) ____

POWER TYPE (Circle One): (Electric), Tractor, Diesel, Gasoline, Butane, Other (Describe) ____

Pump Capacity (GPM)	No. of Stages	Setting Depth
10	2	— FT.

PUMP TEST

Well yielded ____ GPM with a drawdown of ____ ft. after ____ hours of pumping

WELL DATA

Well Depth	Casing Diameter (In.)	Casing Length (Ft.)
188/183	2"	173'

Type of Casing	Hole Depth	Depth to Static Water Level
PVC	188'	25'

TYPE OF COMPLETION: (Circle One or More): Gravel Packed, Underreamed, Telescoped, (Natural Development), Open Hole, Other (Describe) ____

Top of Lap Pipe or Reduction in Casing: FEET

IF TELESCOPED OR MORE THAN ONE SCREEN: USE BACK PAGE

LOG DATA

TYPE OF LOG RUN (Circle One): (No Log Run), Electric, Gamma Ray, Density, Sonic, Neutron, Other (Describe) ____

Name of Organization Running Log

GEOLOGIC DATA (Office Use Only)

Surface Elev.	Geologic Unit	Unit Thickness	Depth to Top
Subs. SWL	Date	Analysis	Aquifer Test

Driller's Remarks

SCREEN DATA

Diameter - Inches	Length - Feet	Slot Size - Inches
2"	10'	.008

Screen Type	Depth to Bottom - Feet
PVC	183'

RECEIVED
NOV 24 1986
Department of Natural Resources
Bureau of Land & Water Resources

DESCRIPTION OF FORMATIONS ENCOUNTERED	FROM	TO
Brown Clay	0	14
White Coarse Sand	14	25
Blue Clay	25	47
White Coarse Sand	47	103
Blue Clay	103	151
Fine Gray Sand	151	165
Gray Med Sand	165	183
Blue Clay	183	188

FORMATIONS (Continued)	FROM	TO

IF MORE SPACE IS NEEDED, USE BACK

If well telescopes please sketch and show depths.

GROUND LEVEL

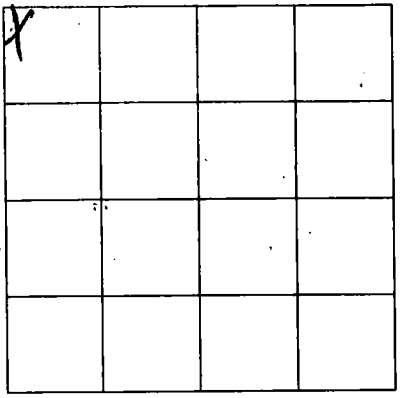

SECTION 7

Please indicate well location X.

ADDITIONAL INFORMATION

If more than one screen, show location of each on sketch.