# MISSISSIPPI DEPARTMENT OF NATURAL RESOURCES

Bureau of Land and Water Resources

P.O. Box 10631
Jackson, Mississippi 39209

WATER WELL DRILLERS LOG

COUNTY WELL LOCATED: Jackson

WELL NUMBER: M 9199

CODED:

PERMIT NUMBER:

NAME OF DRILLING FIRM: Coast Water Well

DATE WELL COMPLETED: 7-8-88

NAME & MAILING ADDRESS OF LANDOWNER:
Lynn Presley
10400 Gordon McClake
Pascagoula Ms

WELL LOCATION: SEC 36 TOWNSHIP 6 N (S) RANGE 5 E (W)

DISTANCE: — Miles DIRECTION: — NEAREST TOWN: of FRANKLIN CREEK

OTHER LANDMARK:

WELL PURPOSE: Home, Irrigation, Municipal, Industrial, Fish Pond, etc.: home

## PUMP DATA

PUMP TYPE (Circle One): Submersible, Turbine, (Jet) Flowing Well, Other (Describe)

POWER TYPE (Circle One): (Electric) Tractor, Diesel, Gasoline, Butane, Other (Describe)

| Pump Capacity (GPM) | No. of Stages | Setting Depth |
|---|---|---|
| 10 | 1 | — FT. |

PUMP TEST

Well yielded — GPM with a drawdown of — ft. after — hours of pumping

## WELL DATA

| Well Depth | Casing Diameter (In.) | Casing Length (Ft.) |
|---|---|---|
| 135' 130 | 2" | 120' |

| Type of Casing | Hole Depth | Depth to Static Water Level |
|---|---|---|
| PVC | 135' | 15' |

TYPE OF COMPLETION: (Circle One or More): Gravel Packed, Underreamed, Telescoped, (Natural Development) Open Hole, Other (Describe)

Top of Lap Pipe or Reduction in Casing: FEET

IF TELESCOPED OR MORE THAN ONE SCREEN: USE BACK PAGE

## SCREEN DATA

| Diameter - Inches | Length - Feet | Slot Size - Inches |
|---|---|---|
| 2" | 10' | .008 |

| Screen Type | Depth to Bottom - Feet |
|---|---|
| PVC | 130' |

## LOG DATA

TYPE OF LOG RUN (Circle One): (No Log Run) Electric, Gamma Ray, Density, Sonic, Neutron, Other (Describe)

Name of Organization Running Log:

## GEOLOGIC DATA (Office Use Only)

| Surface Elev. | Geologic Unit | Unit Thickness | Depth to Top |
|---|---|---|---|
| Subs. SWL | Date | Analysis | Aquifer Test |

Driller's Remarks:

RECEIVED
NOV 15 1988
Department of Natural Resources
Bureau of Land & Water Resources

| DESCRIPTION OF FORMATIONS ENCOUNTERED | FROM | TO |
|---|---|---|
| Brown Clay | 0 | 7 |
| White Coarse Sand | 7 | 29 |
| Blue Clay | 29 | 76 |
| White Coarse Sand & Gravel | 76 | 87 |
| Blue Clay | 87 | 110 |
| White Coarse Sand | 110 | 133 |
| Blue Clay | 133 | 135 |

| FORMATIONS (Continued) | FROM | TO |
|---|---|---|
| | | |

IF MORE SPACE IS NEEDED, USE BACK

If well telescopes please sketch and show depths.

GROUND LEVEL

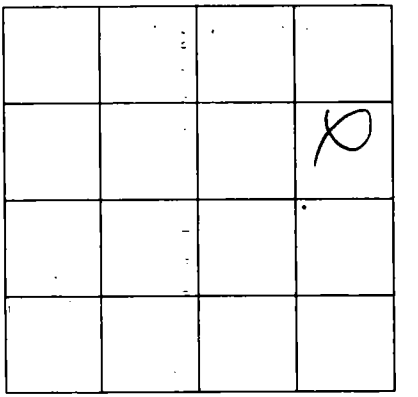


SECTION 36

Please indicate well location X.

ADDITIONAL INFORMATION

If more than one screen, show location of each on sketch.