

N 101  
7-26-60

N 308

WATER WELL DRILLERS LOG

Date: 7-26, 1960, Driller: N'brg Butane County Jackson  
65 (Name)

(1) Owner of Land: W.D. Ross  
(Name)  
Nudson Road, Ocean Springs  
(Address)  
(2) Location: 1/4, 1/4, Sec. T R,  
(\* Lot #60 Holcomb Subdivision),  
1/2 miles South, of Ocean Springs  
(distance) (direction) (Nearest Town)  
(inside city limits)  
(3) Topography: X  
(Hilly) (Flat) (Level)  
(4) Purpose of Well: domestic  
(Domestic Irrigation  
Municipal, Industrial, Other)


Description & Color of Materials Sand, Clay, Red Clay, Shell, etc.	Thick- ness Feet	Depth Feet
white sand	0-20	
" "	20-50	
blue clay	50-60	
white sand	60-80	
gravel + sand	80-150	
blue clay	150-320	
" sand	320-335	

Information upon completion of well:


(1) Diameter 2 inches.  
(2) Total Depth 335 feet.  
(3) Water Level \_\_\_\_\_ feet below top of ground.  
(4) Cased to \_\_\_\_\_, Size \_\_\_\_\_  
(5) Screen: Size 2", Length 10'  
(6) Were any formations sealed against pollution?  
\_\_\_\_\_ yes, X no.

If YES depth of formation \_\_\_\_\_  
Why \_\_\_\_\_

Drillers Remarks: \_\_\_\_\_

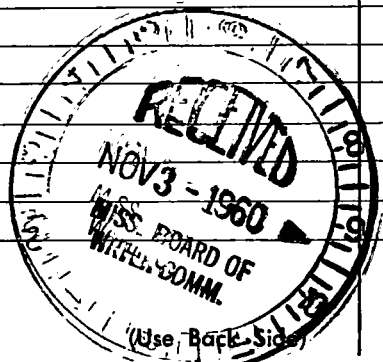

Well No.

 

