

Jackson
N170

MISSISSIPPI BOARD OF WATER COMMISSIONERS

7-66

WATER WELL DRILLERS LOG

Date: 7-11, 1966, Driller: C.T. Switzer Well Co. County Jackson
45 (When well drilled) (Name) (Where well is located)

(1) Owner of Land: Hugh M. Dowling
(Name)

Old Highway 90 - east of Ocean Springs, Miss
(Address)

(2) Location: SW 1/4, SW 1/4, Sec. 26 T7 S RB W
_____ miles _____ of _____
(distance) (direction) (Nearest Town)

(3) Topography: X
(Hilly) (Flat) (Level)

(4) Purpose of Well: domestic
(Domestic Irrigation
Municipal, Industrial, Other)

Description & Color of Materials Sand, Clay, Red Clay, Shell, etc.	Thick- ness Feet	Depth Feet
clay	0	5
sand	5	21
clay	21	76
sand	76	81
clay	81	86
sand	86	101
mixed	101	121
sand	121	171

Information upon completion of well:

(1) Diameter 2 inches.

(2) Total Depth 171 feet.

(3) Water Level 22 feet below top of ground.

(4) Cased to 171'; Size 2"

(5) Screen: Size 1/2 ga 55, Length 10'

(6) Were any formations sealed against pollution?
X yes, _____ no.

If YES depth of formation _____


Why Health Dept. Reagents

Drillers Remarks: _____

Yield in gpm: _____

Size pump: _____

Type power: _____

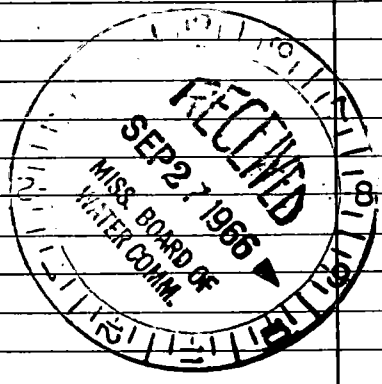





