

Jackson
N 172

9-66

MISSISSIPPI BOARD OF WATER COMMISSIONERS

WATER WELL DRILLERS LOG

Date: 9-21, 1966, Driller C.T. Switzer Well Co. County Jackson
45 (When well drilled) (Name) (Where well is located)

(1) Owner of Land: <u>Anthony Adams</u> (Name)	Description & Color of Materials Sand, Clay, Red Clay, Shell, etc.	Thick- ness Feet	Depth Feet
<u>Box 580-D. Biloxi, Miss.</u> (Address)	<u>topsoil</u>	<u>0</u>	<u>6</u>
(2) Location: <u>SE 1/4, SE 1/4, Sec. 11 T7 R9</u>	<u>clay</u>	<u>6</u>	<u>133</u>
_____ miles _____ of _____ (distance) (direction) (Nearest Town)	<u>sand</u>	<u>133</u>	<u>159</u>
(3) Topography: <u>X</u> (Hilly) (Flat) (Level)			
(4) Purpose of Well: <u>domestic</u> (Domestic Irrigation Municipal, Industrial, Other)			

Information upon completion of well:

(1) Diameter 2 inches.

(2) Total Depth 159 feet.

(3) Water Level 9'6" feet below top of ground.

(4) Cased to 159', Size 2"

(5) Screen: Size 8ga ss, Length 10'

(6) Were any formations sealed against pollution?
X yes, _____ no.

If YES depth of formation _____


Why Health Dept. Regments.

Drillers Remarks: _____

Yield in gpm: _____

Size pump: _____

Type power: _____

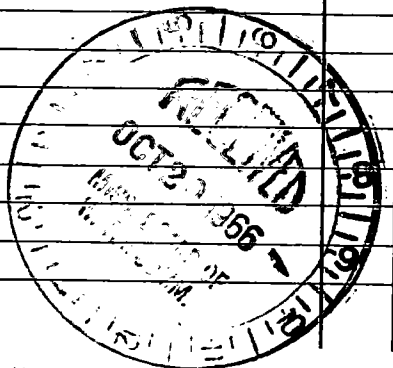




