Jackson
N 222
6-24-68

MISSISSIPPI
BOARD OF WATER COMMISSIONERS
416 North State Street
Jackson, Mississippi 39201

CODED

WATER WELL DRILLERS LOG

6-24 1968 Coast Water Well Serv. Jackson
date well completed — firm name — county well located

LANDOWNER: H. A. Morrison
603 Clark Ave.
Ocean Springs, Miss.
(mailing address)

WELL LOCATION:
sec. 29 T 7 ~~N~~ S R 8 ~~E~~ W
city (distance) miles limits (direction) of Ocean Springs (nearest town)

WELL PURPOSE: Yard irrigation
(home, irrigation, municipal, industrial)

WELL COMPLETION DATA:

(1) diameter (inches) 2"
(2) total depth (feet) 68
(3) static water level (feet) 17 below ~~above~~ top of ground.
(4) casing 2" pvc (material), 63' (depth), 2" (size) if telescope see back.
(5) screen 5' (length), 63' (depth to top), 2" (size), plastic (pvc) (material)
(6) pump 1/2 (HP) 10 (yield gpm) Elec. (type power)
(7) electric log NO (yes or no)
(organization running log)
(8) how well bottom plugged Back wash Valve

DRILLERS REMARKS:

description of formations encountered	from	to
Red & white Clay	0	12
Fine sand	12	30
Blue Clay & fine sand	30	47
Sand Med-Coarse	47	68

PROCESSED

DEC 19 1968
MISS. BD. OF WATER COMM.

If well telescopes please sketch and show depths.

GROUND LEVEL

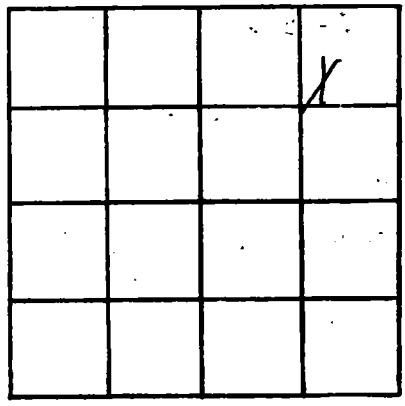

SECTION 29

Please indicate well location X.

ADDITIONAL INFORMATION

If more than one screen, show locations of each on sketch.