Jackson
N 243
5-2-69

CODED

MISSISSIPPI
BOARD OF WATER COMMISSIONERS
416 North State Street
Jackson, Mississippi 39201

WATER WELL DRILLERS LOG

May 2 1969 L. L. Garland Water Wells Jackson
date well completed — firm name — county well located

LANDOWNER: Leon Quave
246 Oak St.
Biloxi, Miss
(mailing address)

WELL LOCATION:
sec. 13 T 7 N (S) R 9 E (W)
2 (distance) miles S.W. (direction) of A.S. (nearest town)

WELL PURPOSE: home
(home, irrigation, municipal, industrial)

WELL COMPLETION DATA:

(1) diameter (inches) 2"
(2) total depth (feet) 472
(3) static water level (feet) 18 below (above) top of ground.
(4) casing Steel (material), 462 ft (depth)
2 (size) if telescope see back.
(5) screen 10 ft (length), 462 (depth to top)
8 gauge 2" (size), S. Steel (material)
(6) pump 1/2 (HP) 750 gal per hr (yield gpm)
Electric (type power)
(7) electric log _____ (yes or no)
_____ (organization running log)
(8) how well bottom plugged B.W. Valve

DRILLERS REMARKS:
37 ft. Water bearing sand

description of formations encountered	from	to

MAY 23 1969
MISS. BD. OF WATER COMM.

If well telescopes please sketch and show depths.

GROUND LEVEL

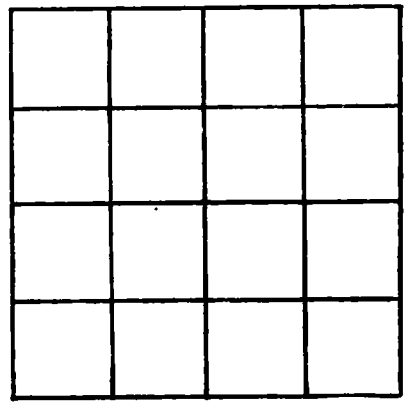

SECTION _____

Please indicate well location X.

ADDITIONAL INFORMATION

If more than one screen, show locations of each on sketch.