JACKSON
N344
4-21-71

MISSISSIPPI
BOARD OF WATER COMMISSIONERS
416 North State Street
Jackson, Mississippi 39201

WATER WELL DRILLERS LOG

CODED

4-21-71 19 — date well completed
R. V. Moore — firm name
JACKSON — county well located

LANDOWNER: IVY HEBERT
POA PATCH ROAD
BILOXI, MISS
(mailing address)

WELL LOCATION:
sec. 3 T 7 N (S) R 9 E (W)
5 miles N of BILOXI
(distance) (direction) (nearest town)

WELL PURPOSE:
(home, irrigation, municipal, industrial)

WELL COMPLETION DATA:
(1) diameter (inches) 2"
(2) total depth (feet) 399'
(3) static water level (feet) 24' below above top of ground.
(4) casing PVC (material), 3 (depth),
(size) if telescope see back.
(5) screen 2x20 (length), 379 (depth to top)
2" (size), SS (material)
(6) pump 1 (HP) 16 (yield gpm)
E (type power)
(7) electric log (yes or no)
(organization running log)
(8) how well bottom plugged BW
Vibra

DRILLERS REMARKS:

description of formations encountered	from	to
TOP SOIL	0	10
WHITE CLAY	10	30
RUSTY SAND	30	51
BLUE CLAY	51	219
FINE BLUE SAND	211	251
BLUE CLAY	251	370
GRAY SAND	377	399

CODED

APR 28 1971
MISS. BD. OF WATER COMM.

If well telescopes please sketch and show depths.

GROUND LEVEL

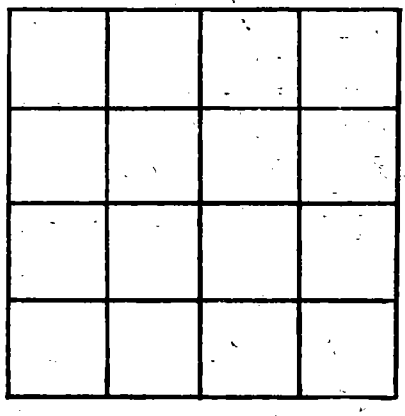

SECTION _____

Please indicate well location X.

ADDITIONAL INFORMATION

If more than one screen, show locations of each on sketch.