JACKSON
N405
4-18-72

MISSISSIPPI
BOARD OF WATER COMMISSIONERS
416 North State Street
Jackson, Mississippi 39201

CODED

WATER WELL DRILLERS LOG

4/18 1972 Coast Water Well Serv. Jackson
date well completed — firm name — county well located

LANDOWNER: Martin Barron
Rt. 3 Biloxi, Miss
Big Ridge Road
(mailing address)

WELL LOCATION:
sec. 12 T 7 S R 9 W
3 (distance) miles N (direction) of Ocean Springs (nearest town)

WELL PURPOSE: home
(home, irrigation, municipal, industrial)

WELL COMPLETION DATA:
(1) diameter (inches) 2"
(2) total depth (feet) 480'
(3) static water level (feet) 30' below ~~above~~ top of ground.
(4) casing PVC (material), 470' (depth), 2" (size) If telescope see back.
(5) screen 10' (length), 470' (depth to top), 2" (size), plastic (material)
(6) pump 1 (HP) 12 (yield gpm) elec. (type power)
(7) electric log NO (yes or no)
(organization running log)
(8) how well bottom plugged backwash Valve

DRILLERS REMARKS:

description of formations encountered	from	to
top soil	0	5
fine sand	5	25
yellow clay	25	35
Blue clay	35	55
gravel	55	63
log + gravel	63	75
Blue clay	75	135
fine to med. sand	135	215
Streaks course sand	215	240
Blue clay	240	395
med [illegible] sand	395	399
course to med. sand	399	480

CODED

SEP 28 1972
MISSISSIPPI BOARD OF WATER COMMISSIONERS

If well telescopes please sketch and show depths.

GROUND LEVEL

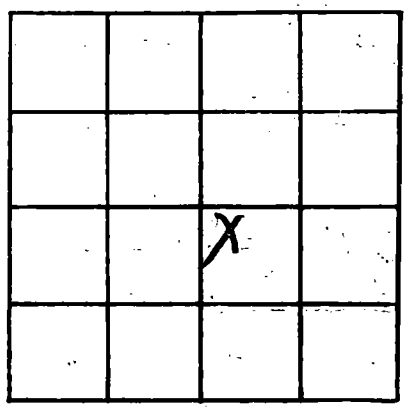

SECTION 12

Please indicate well location X.

ADDITIONAL INFORMATION

If more than one screen, show locations of each on sketch.