JACKSON
N421
1-5-73

MISSISSIPPI
BOARD OF WATER COMMISSIONERS
416 North State Street
Jackson, Mississippi 39201

CODED

WATER WELL DRILLERS LOG

1-5 1973 Surtges Well Co. Jackson
date well completed — firm name — county well located

LANDOWNER: C.H. Bennett
Rt 3 Box 256
Biloxi, Miss 39532
(mailing address)

WELL LOCATION:
sec. 11 T 7 S R 9 W
2 miles N of Ocean Springs
(distance) (direction) (nearest town)

WELL PURPOSE: home
(home, irrigation, municipal, industrial)

WELL COMPLETION DATA:

(1) diameter (inches) 2"
(2) total depth (feet) 442'
(3) static water level (feet) 48' below ~~above~~ top of ground.
(4) casing galv. (material), 442' (depth),
_____ (size) if telescope see back.
(5) screen 10' (length), 432' (depth to top)
008 (size), stainless steel (material)
(6) pump 1 jet (HP) 10 (yield gpm)
Electric (type power)
(7) electric log no (yes or no)
_____ (organization running log)
(8) how well bottom plugged back pressure valve

DRILLERS REMARKS:

description of formations encountered	from	to
clay	0	23
sand	23	33
clay	33	47
sand	47	61
clay	61	152
clay-sand str.	152	173
clay	173	194
fine sand	194	203
clay	203	215
clay-sand str	215	236
clay	236	250
sand	250	254
clay	254	321
fine sand	321	342
clay	342	352
sand	352	360
clay	360	383
sand good	383	442

CODED

FEB 6
MISS. BD. OF
WATER COMM

If well telescopes please sketch and show depths.

GROUND LEVEL

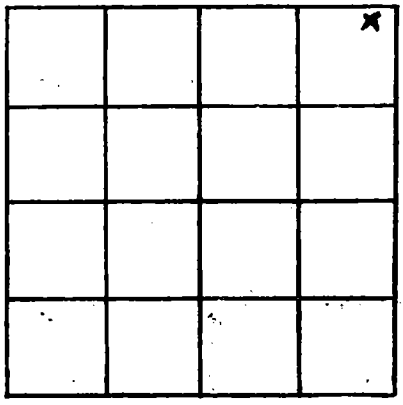

SECTION 11

Please indicate well location X.

ADDITIONAL INFORMATION

If more than one screen, show locations of each on sketch.