JACKSON
N425
7-20-73
Log # 210

MISSISSIPPI
BOARD OF WATER COMMISSIONERS
416 North State Street
Jackson, Mississippi 39201

CODED

WATER WELL DRILLERS LOG

7-20-73 19 — date well completed
Sutter Well Works — firm name
Jackson — county well located

LANDOWNER: Gulf Park Estates
Ocean Springs, Miss.
#1 well
(mailing address)

WELL LOCATION: Corresp. to USGS records Sec. 33 T. 7 S R. 8 W
miles (distance) E (direction) of Ocean Springs (nearest town)

WELL PURPOSE: sub-division
(home, irrigation, municipal, industrial)

WELL COMPLETION DATA:

(1) diameter (inches) 6" x 10"
(2) total depth (feet) 1058'
(3) static water level (feet) 10' below top of ground.
(4) casing blk.steel (material), (depth), 6 & 10" (size) if telescope see back.
(5) screen 50' (length), 1005' (depth to top), 6" (size), stainless steel (material)
(6) pump 30 (HP) 350 (yield gpm) elec. (type power)
(7) electric log yes (yes or no) USGS (organization running log)
(8) how well bottom plugged B.P.Valve

DRILLERS REMARKS:

Description of formations encountered	from	to
Sand & Mud	0	178
Sand	178	218
Clay-Sand Streaks	218	540
Sand	540	555
Clay-Sand Streaks	555	902
Sand	902	928
Clay	928	976
Sand	976	1058

CODED

MAY 2 8 1970
MISS. BD. OF
WATER COMMISS.

If well telescopes please sketch and show depths.

GROUND LEVEL

811' of 10" casing

243' of 6" casing

51' screen and valve

18" of 6" pipe under strainer

If more than one screen, show locations of each on sketch.

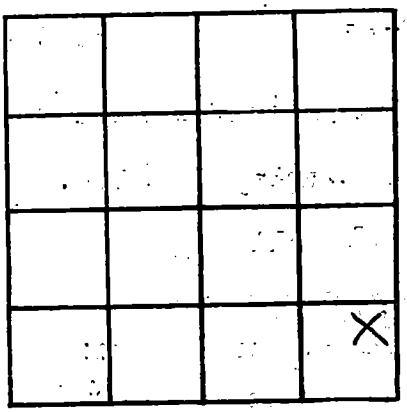

SECTION 33

Please indicate well location X.

ADDITIONAL INFORMATION