Jackson
N 454
3-14-69

MISSISSIPPI
BOARD OF WATER COMMISSIONERS
416 North State Street
Jackson, Mississippi 39201

CODED

WATER WELL DRILLERS LOG

March 14 1969 L.L. Garland Water Wells Jackson
date well completed — firm name — county well located

LANDOWNER: G.L. Adams
P.O. Box 403
Bogalusa, La
(mailing address)

WELL LOCATION:
sec. 33 T 7 N (S) R 8 E (W)
5 miles South of O.S.
(distance) (direction) (nearest town)

WELL PURPOSE: home
(home, irrigation, municipal, industrial)

WELL COMPLETION DATA:

(1) diameter (inches) 2
(2) total depth (feet) 441
(3) static water level (feet) 2 1/2 (below) above top of ground.
(4) casing steel (material), 431 (depth), 2" (size) If telescope see back.
(5) screen 10 ft. (length), 431 (depth to top), 2 (size), bronze (material)
(6) pump Customer (HP) (yield gpm) installed (type power)
(7) electric log No (yes or no)
(organization running log)
(8) how well bottom plugged W. Valve

DRILLERS REMARKS:
27 ft. of
Water bearing sand

description of formations encountered	from	to
CODED		

MAR 17 1969
MISS. BD. OF WATER COMM.

If well telescopes please sketch and show depths.

GROUND LEVEL

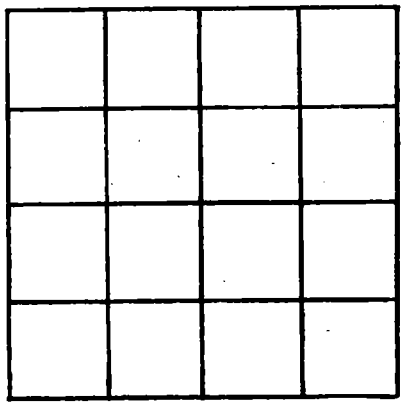

SECTION 33

Please indicate well location X.

ADDITIONAL INFORMATION

If more than one screen, show locations of each on sketch.