Jackson
N 475
6-25-25

MISSISSIPPI
BOARD OF WATER COMMISSIONERS
416 North State Street
Jackson, Mississippi 39201

CODED

WATER WELL DRILLERS LOG

June 25 1975 GARLAND WATER WELLS Jackson
date well completed firm name county well located

LANDOWNER: MAY JORDAN
20016 KENSINGTON DR
OCEAN SPRINGS, MS
(mailing address) 39564

WELL LOCATION:
sec. 31 T 7 ~~N~~ S R 8 ~~E~~ W 135
IN O/S CITY LIMITS
(distance) miles (direction) of (nearest town)

WELL PURPOSE: IRRIGATION
(home, irrigation, municipal, industrial)

WELL COMPLETION DATA:

(1) diameter (inches) 2"
(2) total depth (feet) 146'
(3) static water level (feet) 12½' below ~~above~~ top of ground.
(4) casing PVC (material), 139' (depth),
2" (size) if telescope see back.
(5) screen 5' (length), 146'-139' (depth to top)
2" (size), PVC GRAVEL PACKED (material)
(6) pump ½ HP (HP) 8 (yield gpm)
ELECTRIC (type power)
(7) electric log No (yes or no)
N/A (organization running log)
(8) how well bottom plugged FLOAT BALL

DRILLERS REMARKS:

description of formations encountered	from	to
TOP SOIL	0	2
SAND - COURSE WHITE	2	151
SHELL + GRAVEL	151	

Driller Verified
DATE 8-25-75

MISS. BD. OF WATER COMM.

If well telescopes please sketch and show depths.

GROUND LEVEL

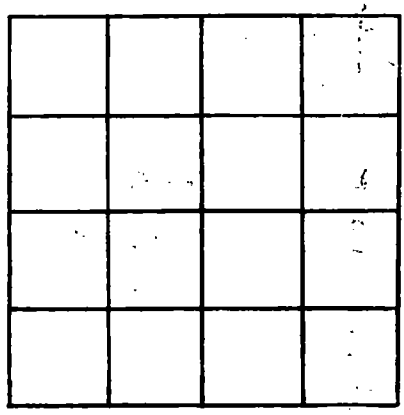

SECTION _____

Please indicate well location X.

ADDITIONAL INFORMATION

If more than one screen, show locations of each on sketch.