Jackson
N
N2139

MISSISSIPPI DEPARTMENT OF NATURAL RESOURCES
Bureau of Land and Water Resources
Southport Mall
P.O. Box 10631
Jackson, Mississippi 39209

WATER WELL DRILLERS LOG

5-30-86, 19 — date well completed
Coastwaterwell — firm name
Jackson — county well located

LANDOWNER: James Jordan
14604 Parker Rd
Ocean Springs MS
(mailing address)

WELL LOCATION:
sec. 2 T. 7 S R. 9 E
1½ miles N of Diberville
(distance) (direction) (nearest town)

WELL PURPOSE: home
(home, irrigation, municipal, industrial)

WELL COMPLETION DATA:
(1) diameter (inches) 2"
(2) total depth (feet) 265'
(3) static water level (feet) 37 below/above top of ground.
(4) casing PVC (material), 250 (depth), 2" (size) if telescope see back.
(5) screen 10' (length), 250' (depth to top), 2" (size), PVC (material)
(6) pump — (HP) — (yield gpm)
— (type power)
(7) electric log no (yes or no)
— (organization running log)
(8) how well bottom plugged backwash valve

DRILLERS REMARKS:
5'-2" PVC tailpipe

description of formations encountered	from	to
Top Soil	0	2
Brown Clay	2	29
White Coarse Sand + Pea Gravel	29	44
Brown Clay	44	50
White Coarse Sand	50	53
Blue Clay	53	70
White Coarse Sand	70	83
Blue Clay	83	235
Gray Med Sand	235	260
Blue Clay	260	265
		wdw
250		
10		
with 60		

RECEIVED
JUL 18 1986
Department of Natural Resources
Bureau of Land & Water Resources

If well telescopes please sketch and show depths.

GROUND LEVEL

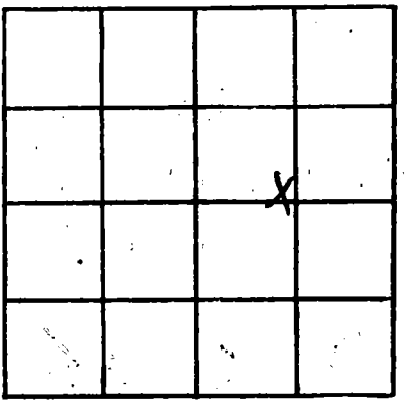

SECTION 2

Please indicate well location X.

ADDITIONAL INFORMATION

If more than one screen, show locations of each on sketch.