# Jackson N2225

**MISSISSIPPI DEPARTMENT OF NATURAL RESOURCES**
**Bureau of Land and Water Resources**
**Southport Mall**
**P.O. Box 10631**
**Jackson, Mississippi 39209**

## WATER WELL DRILLERS LOG

12-12-84 19 Coast Water Well Serv. Jackson
date well completed — firm name — county well located

LANDOWNER Ken F. Ames
1210 Lynpit Ave
Ocean Springs, Miss.
(mailing address) 39564

WELL LOCATION:
sec. 7 T 7 N (S) R 8 E (W)
2 miles N of OCEAN SPRINGS
(distance) (direction) (nearest town)

WELL PURPOSE: Home
(home, irrigation, municipal, industrial)

WELL COMPLETION DATA:
(1) diameter (inches) 2"
(2) total depth (feet) 365'
(3) static water level (feet) 70' below ~~above~~ top of ground.
(4) casing PVC (material), 355' (depth), 2" (size) If telescope see back.
(5) screen 10' (length), 355' (depth to top), 2" (size), PVC (material)
(6) pump 2 h.p. (HP) 10 (yield gpm) Elect. (type power)
(7) electric log No. (yes or no)
(organization running log)
(8) how well bottom plugged Rock Wash Value

DRILLERS REMARKS:

| description of formations encountered | from | to |
|---|---|---|
| Red Clay | 0 | 5' |
| White Sand | 5' | 40' |
| Blue Clay | 40' | 85' |
| White Sand | 85' | 100' |
| Blue Clay | 100' | 150' |
| White Sand | 150' | 194' |
| Blue Clay | 194' | 340' |
| White Sand | 340' | 365' |

1-8-85
JHW

If well telescopes please sketch and show depths.

GROUND LEVEL

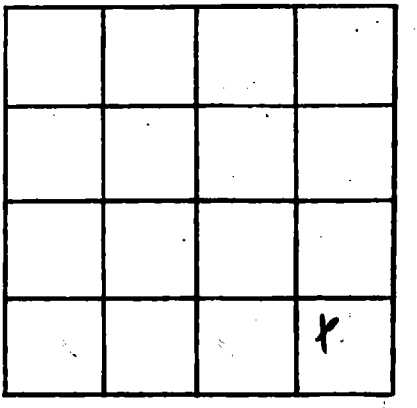


SECTION 7

Please indicate well location X.

ADDITIONAL INFORMATION

If more than one screen, show locations of each on sketch.