N# 22-27
JACKSON
12-11-84

MISSISSIPPI DEPARTMENT OF NATURAL RESOURCES

Bureau of Land and Water Resources
Southport Mall
P.O. Box 10631
Jackson, Mississippi 39209

WATER WELL DRILLERS LOG

12-11-84 19 — Coast Water Well Serv. — Jackson
date well completed — firm name — county well located

LANDOWNER: Randy Stolnick
1411 Lemoyne Blvd
Biloxi, Miss. 39532
(mailing address)

WELL LOCATION:
sec. 13 T 7 N (S) R 9 E (W)
2 (distance) miles NW (direction) of Ocean Springs (nearest town)

WELL PURPOSE: Home
(home, irrigation, municipal, industrial)

WELL COMPLETION DATA:

(1) diameter (inches) ~~4.75~~ 2"
(2) total depth (feet) 473'
(3) static water level (feet) 75' (below) above top of ground.
(4) casing PVC (material), 453' (depth), 2" (size) If telescope see back.
(5) screen 20' (length), 453' (depth to top), 2" (size), PVC (material)
(6) pump 2 h.p. (HP) 10 (yield gpm) Elect. (type power)
(7) electric log No (yes or no)
(organization running log)
(8) how well bottom plugged Back Wash Valve

DRILLERS REMARKS:

description of formations encountered	from	to
Red Clay	0	5'
Blue Clay	5'	50'
White Coarse Sand	50'	65'
Blue Clay, White strip Sand	65'	205'
White sand & Strip Clay	205'	230'
Blue Clay	230'	301'
Blue Clay - w/ Shells	301'	344'
Blue Clay	344'	420'
Coarse Sand - Salt & Pepper	420'	473'

RECEIVED
APR 2 - 1985
Department of Natural Resources
Bureau of Land & Water Resources

If well telescopes please sketch and show depths.

GROUND LEVEL

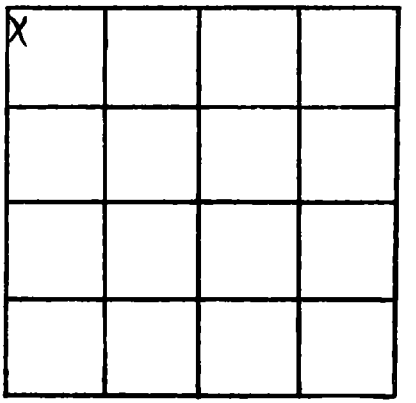

SECTION 13

Please indicate well location X.

ADDITIONAL INFORMATION

If more than one screen, show locations of each on sketch.