Jackson
N 2246
6-4-85

MISSISSIPPI DEPARTMENT OF NATURAL RESOURCES
Bureau of Land and Water Resources
Southport Mall
P.O. Box 10631
Jackson, Mississippi 39209

WATER WELL DRILLERS LOG

6-4-85 19 Coast Water Well Serv. Jackson
date well completed — firm name — county well located

LANDOWNER: Dr. John LaCroix
7405 Tucker Rd.
Ocean Springs, Miss.
(mailing address) 39564

WELL LOCATION:
sec. 13 T 7 N/S R 9 E/W
2 miles NW of OCEAN SPRINGS
(distance) (direction) (nearest town)

WELL PURPOSE: Home
(home, irrigation, municipal, industrial)

WELL COMPLETION DATA:
(1) diameter (inches) 2"
(2) total depth (feet) 490'
(3) static water level (feet) 75' below/above top of ground.
(4) casing PVC (material), 470' (depth),
2" (size) If telescope see back.
(5) screen 20' (length), 470' (depth to top)
2" (size), PVC (material)
(6) pump 2hp. (HP) 12 (yield gpm)
Elect. (type power)
(7) electric log No (yes or no)
(organization running log)
(8) Has well bottom plugged? Back wash Valve

DRILLERS REMARKS:

description of formations encountered	from	to
Top soil	0	2'
Red Clay	2	15'
Coarse White sand	15'	30'
Sand & Pea gravel	30'	45'
Sand-strip Clay	45'	60
Blue Clay (Strip sand)	60'	150'
Blue Clay	150'	205'
Med. Gray sand	205'	230'
Blue Clay	230'	340'
Blue Clay Strip sand	340'	410'
Med. Sand	410'	450'
Coarse Pepper sand	450'	490'

RECEIVED
JUL 11 1985
Department of Natural Resources
Bureau of Land & Water Resources

If well telescopes please sketch and show depths.

GROUND LEVEL

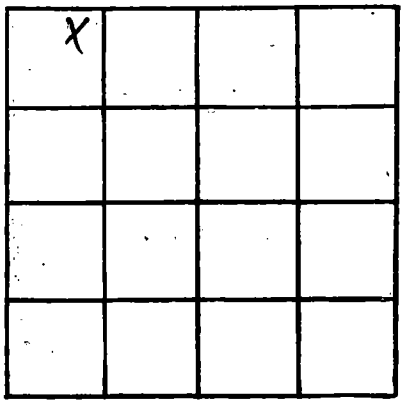

SECTION 13

Please indicate well location X.

ADDITIONAL INFORMATION

If more than one screen, show locations of each on sketch.