Jackson
N 2254

MISSISSIPPI DEPARTMENT OF NATURAL RESOURCES

Bureau of Land and Water Resources
Southport Mall
P.O. Box 10631
Jackson, Mississippi 39209

WATER WELL DRILLERS LOG

July 23, 1985 19 Coast Water Well Jackson
date well completed — firm name — county well located

LANDOWNER: Samuel Bourne
14908 Glendall Rd.
Ocean Springs ms
(mailing address) 39564

WELL LOCATION:
sec. 2 T 7 S R 9 W
4 miles NNW of Ocean Springs
(distance) (direction) (nearest town)

WELL PURPOSE: home
(home, irrigation, municipal, industrial)

WELL COMPLETION DATA:

(1) diameter (inches) 2"

(2) total depth (feet) 435'

(3) static water level (feet) 75 below above top of ground.

(4) casing PVC (material), 420 (depth), 2" (size) if telescope see back.

(5) screen 10' (length), 420 (depth to top), 2" (size), PVC (material)

(6) pump 1 (HP) 5 (yield gpm)
elec (type power)

(7) electric log no (yes or no)
(organization running log)

(8) how well bottom plugged Backwash valve

DRILLERS REMARKS:

description of formations encountered	from	to
Top Soil	0'	1'
Red Clay	1'	27'
Red Coarse Sand	27'	35'
Red Coarse Sand & Gravel	35'	72'
Blue Clay	72'	360'
Gray Medium Sand	360'	390'
Gray Coarse Sand	390'	435'

RECEIVED
NOV - 5 1985
Department of Natural Resources
Bureau of Land & Water Resources

If well telescopes please sketch and show depths.

GROUND LEVEL

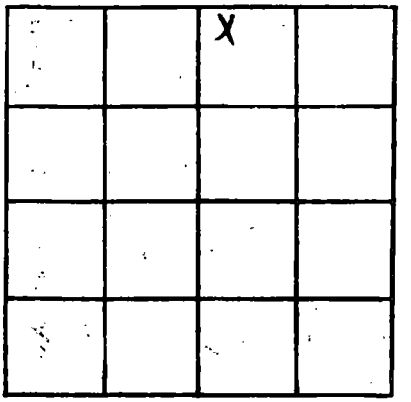

SECTION 2

Please indicate well location X.

ADDITIONAL INFORMATION

If more than one screen, show locations of each on sketch.