MISSISSIPPI DEPARTMENT OF NATURAL RESOURCES

Bureau of Land and Water Resources

P.O. Box 10631
Jackson, Mississippi 39209

WATER WELL DRILLERS LOG

COUNTY WELL LOCATED: Jackson	
WELL NUMBER: N2321	CODED
DATE WELL COMPLETED: 10-20-87	
PERMIT NUMBER	
NAME OF DRILLING FIRM: Mar B Drilling Co.	

NAME & MAILING ADDRESS OF LANDOWNER
Hubert Hitt
6402 Old Fort Bayou Rd
Ocean Springs Miss.

WELL LOCATION: SEC 17 TOWNSHIP 7 (S) RANGE 8 (W)

DISTANCE 2 Miles DIRECTION N of NEAREST TOWN Ocean Springs

OTHER LANDMARK

WELL PURPOSE: Home, Irrigation, Municipal, Industrial, Fish Pond, etc.
Home

PUMP DATA

PUMP TYPE (Circle One): (Submersible) Turbine, Jet Flowing Well, Other (Describe)

POWER TYPE (Circle One): (Electric) Tractor, Diesel, Gasoline, Butane, Other (Describe)

Pump Capacity (GPM)	No. of Stages	Setting Depth
18		120 FT.

PUMP TEST

Well yielded _____ GPM with a drawdown of _____ ft. after _____ hours of pumping

WELL DATA

Well Depth	Casing Diameter (In.)	Casing Length (Ft.)
460 455	4" X 2"	445
Type of Casing	**Hole Depth**	**Depth to Static Water Level**
PVC	460	70 ft

TYPE OF COMPLETION: (Circle One or More): Gravel Packed, Underreamed, Telescoped, (Natural Development), Open Hole, Other (Describe)

Top of Lap Pipe or Reduction in Casing FEET

IF TELESCOPED OR MORE THAN ONE SCREEN: USE BACK PAGE

LOG DATA

TYPE OF LOG RUN (Circle One): (No Log Run), Electric, Gamma Ray, Density, Sonic, Neutron, Other (Describe)

Name of Organization Running Log

GEOLOGIC DATA (Office Use Only)

Surface Elev.	Geologic Unit	Unit Thickness	Depth to Top
Subs. SWL	Date	Analysis	Aquifer Test

Driller's Remarks

RECEIVED
NOV 06 1987
Department of Natural Resources
Bureau of Land & Water Resources

SCREEN DATA

Diameter - Inches	Length - Feet	Slot Size - Inches
2	10	.008
Screen Type	**Depth to Bottom - Feet**	
PVC wop	455	

DESCRIPTION OF FORMATIONS ENCOUNTERED	FROM	TO
Clay	0	15
Sd Cl	15	80
Blue Cl	80	220
Sd Cl	220	240
Bl-Cl	240	340
Sd Cl	340	408
Grey Sand	408	457
Blue Cl	457	460+

FORMATIONS (Continued)	FROM	TO

IF MORE SPACE IS NEEDED, USE BACK

If well telescopes please sketch and show depths.

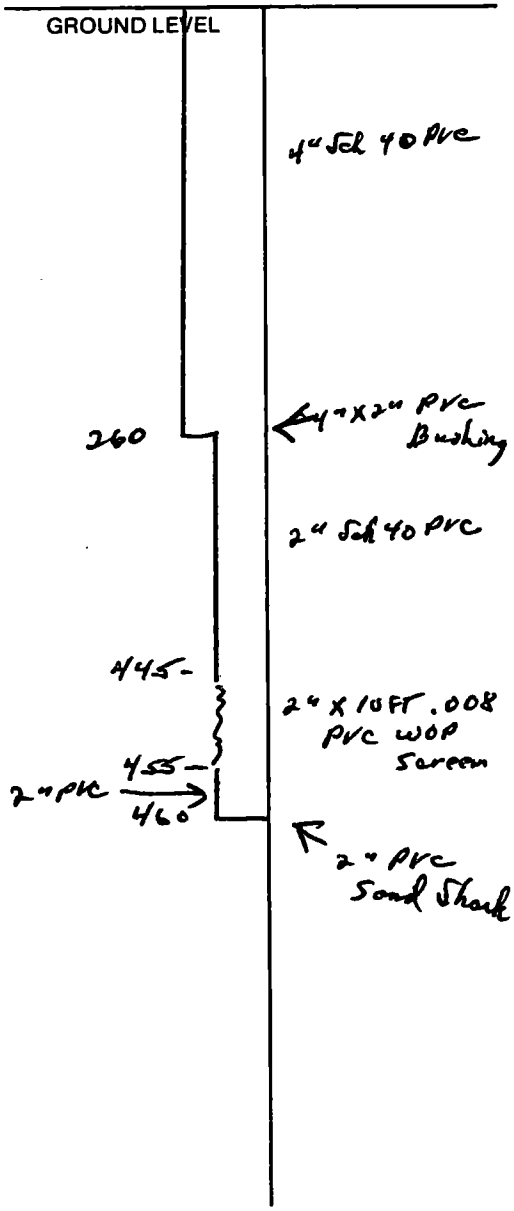

If more than one screen, show location of each on sketch.

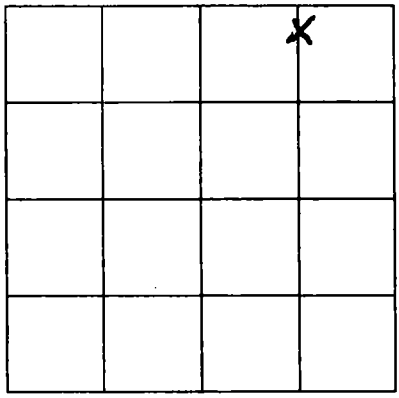

SECTION 17

Please indicate well location X.

ADDITIONAL INFORMATION