MISSISSIPPI DEPARTMENT OF ENVIRONMENTAL QUALITY
Bureau of Land and Water Resources

P. O. Box 10631
Jackson, MS 39289-0631
WATER WELL DRILLERS LOG

COUNTY WELL LOCATED: Jackson	
WELL NUMBER: N 02-411	CODED:
DATE WELL COMPLETED: 5-5-93	
PERMIT NUMBER:	
NAME OF DRILLING FIRM: Coast Water Well Ser Inc.	

NAME & MAILING ADDRESS OF LANDOWNER
Brad Barnes
7600 Wilson Rd.
Vancleave, Ms. 39564

WELL LOCATION: SEC 1 TOWNSHIP 8 S RANGE 8 E (W)

DISTANCE 3 Miles DIRECTION 56 of NEAREST TOWN Ocean Springs

OTHER LANDMARK

WELL PURPOSE: (Home), Irrigation, Municipal, Industrial, Fish Pond, etc.

PUMP DATA

PUMP TYPE (Circle One): (Submersible), Turbine, Jet, Flowing Well, Other (Describe)

POWER TYPE (Circle One): (Electric), Tractor, Diesel, Gasoline, Butane, Other (Describe) H/P 1

Pump Capacity (GPM)	No. of Stages	Setting Depth
20	9	FT.

PUMP TEST

Well yielded _____ GPM with a drawdown of _____ ft. after _____ hours of pumping

WELL DATA

Well Depth	Casing Diameter (In.)	Casing Length (Ft.)
344' 354'	180' 4" 144'-2'	324
Type of Casing	**Hole Depth**	**Depth to Static Water Level**
PVC	354'	5

TYPE OF COMPLETION: (Circle One or More): Gravel Packed, Underreamed, Telescoped, (Natural Development), Open Hole, Other (Describe)

Top of Lap Pipe or Reduction in Casing FEET

IF TELESCOPED OR MORE THAN ONE SCREEN: USE BACK PAGE

LOG DATA

TYPE OF LOG RUN (Circle One): (No Log Run), Electric, Gamma Ray, Density, Sonic, Neutron, Other (Describe)

Name of Organization Running Log

GEOLOGIC DATA (Office Use Only)

Surface Elev.	Geologic Unit	Unit Thickness	Depth to Top
Subs. SWL	Date	Analysis	Aquifer Test

Driller's Remarks

SCREEN DATA

Diameter - Inches	Length - Feet	Slot Size - Inches
2"	20'	.008
Screen Type		**Depth to Bottom - Feet**
PVC		344'

DESCRIPTION OF FORMATIONS ENCOUNTERED	FROM	TO	FORMATIONS (Continued)	FROM	TO
Top soil	0	2			
Coarse sand	2	70			
Blue Clay	70	165			
Fine sand	165	175			
Blue Clay & sand	175	325			
Coarse sand	325	344			
Blue Clay	344	354			
			IF MORE SPACE IS NEEDED, USE BACK		

JUL 26 1993
Dept. of Environmental Quality
Office of Land & Water Resources

If well telescopes please sketch and show depths.

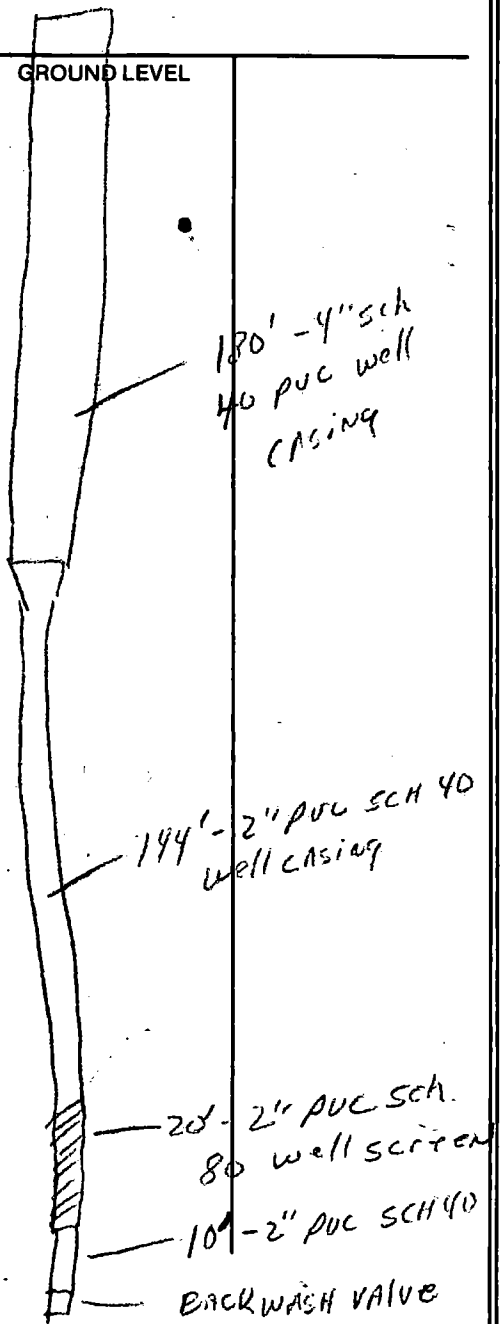

If more than one screen, show location of each on sketch.

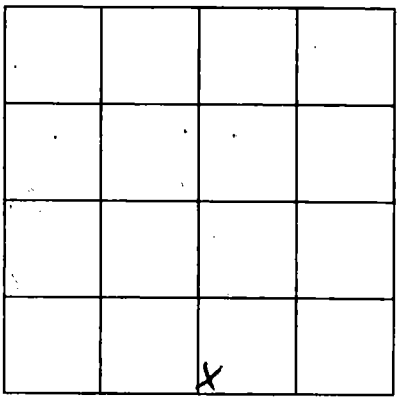

SECTION 1

Please indicate well location X.

ADDITIONAL INFORMATION