MISSISSIPPI DEPARTMENT OF ENVIRONMENTAL QUALITY
Office of Land and Water Resources

P. O. Box 10631
Jackson, MS 39289-0631

WATER WELL DRILLERS LOG

COUNTY WELL LOCATED: Jackson	
WELL NUMBER: N 2537	CODED
DATE WELL COMPLETED: 3-29-98	
PERMIT NUMBER	
NAME OF DRILLING FIRM: Pierce Well	

NAME & MAILING ADDRESS OF LANDOWNER: Jerrell Naremore

Ocean Springs MS

WELL LOCATION	SEC	TOWNSHIP	RANGE
	2	8 (N)	8 (E)

DISTANCE	DIRECTION	NEAREST TOWN
2 Miles	S of	Hwy 90

OTHER LANDMARK:

WELL PURPOSE: (Home) Irrigation, Municipal, Industrial, Fish Pond, etc.

PUMP DATA

PUMP TYPE (Circle One): Submersible, Turbine, (Jet) Flowing Well, Other (Describe)

POWER TYPE (Circle One): (Electric) Tractor, Diesel, Gasoline, Butane, Other (Describe) H/P

Pump Capacity (GPM)	No. of Stages	Setting Depth
10	2	40 FT.

PUMP TEST

Well yielded 10 GPM with a drawdown of 10 ft. after 1 hours of pumping

WELL DATA

Well Depth	Casing Diameter (In.)	Casing Length (Ft.)
170'	2"	160

Type of Casing	Hole Depth	Depth to Static Water Level
Plastic	170'	30'

TYPE OF COMPLETION: (Circle One or More): Gravel Packed, Underreamed, Telescoped, Natural Development, Open Hole, Other (Describe)

WELL GROUTED TO A DEPTH OF 15 FEET
Type Grout (circle one): Cement, Bentonite, or (Mix)

LOG DATA

TYPE OF LOG RUN (Circle One): (No Log Run), Electric, Gamma Ray, Density, Sonic, Neutron, Other (Describe)

Name of Organization Running Log

GEOLOGIC DATA (Office Use Only)

Surface Elev.	Geologic Unit	Unit Thickness	Depth to Top
Subs. SWL	Date	Analysis	Aquifer Test

Driller's Remarks

Top of Lap Pipe or Reduction in Casing: FEET

IF TELESCOPED OR MORE THAN ONE SCREEN: USE BACK PAGE

SCREEN DATA

Diameter - Inches	Length - Feet	Slot Size - Inches
2"	10'	006

Screen Type	Depth to Bottom - Feet
Plastic	170

DESCRIPTION OF FORMATIONS ENCOUNTERED	FROM	TO
Top Soil	0	10
Clay + Sand	10	90
Clay	90	140
Good Sand	140	170

FORMATIONS (Continued)	FROM	TO

06-23-98A09:59 RCVD

IF MORE SPACE IS NEEDED, USE BACK

If well telescopes please
sketch and show depths.

GROUND LEVEL

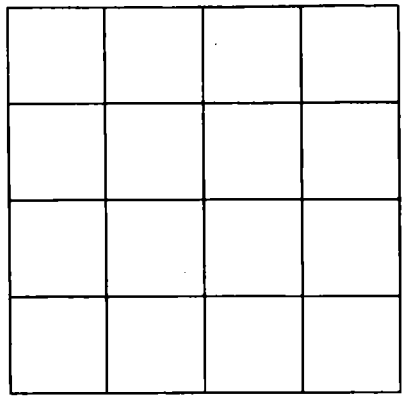

SECTION _____

Please indicate well location X.

ADDITIONAL INFORMATION

If more than one screen,
show location of each on sketch.