**MISSISSIPPI DEPARTMENT OF ENVIRONMENTAL QUALITY**
**Office of Land and Water Resources**

P. O. Box 10631
Jackson, MS 39289-0631
**WATER WELL DRILLERS LOG**

| | |
|---|---|
| COUNTY WELL LOCATED: Jackson | |
| WELL NUMBER: N 2596 | CODED |
| DATE WELL COMPLETED: 10-6-99 | PERMIT NUMBER |
| | NAME OF DRILLING FIRM: Coast Water Well Service |

NAME & MAILING ADDRESS OF LANDOWNER
Joe Holder
[illegible] Rd
Ocean Springs Ms

| WELL LOCATION SEC | TOWNSHIP | RANGE |
|---|---|---|
| 1 | 7 (N) | 9 (E) (W) |

| DISTANCE | DIRECTION | NEAREST TOWN |
|---|---|---|
| 3 1/2 Miles | NORTH of | Ocean Springs |

OTHER LANDMARK

WELL PURPOSE: (Home), Irrigation, Municipal, Industrial, Fish Pond, etc.

## PUMP DATA

PUMP TYPE (Circle One): Submersible, Turbine, (Jet) Flowing Well, Other (Describe) _____

POWER TYPE (Circle One): (Electric) Tractor, Diesel, Gasoline, Butane, Other (Describe) _____ H/P 2

| Pump Capacity (GPM) | No. of Stages | Setting Depth |
|---|---|---|
| 8 | 3 | FT. |

PUMP TEST

Well yielded _____ GPM with

a drawdown of _____ ft.

after _____ hours of pumping

## WELL DATA

| Well Depth | Casing Diameter (In.) | Casing Length (Ft.) |
|---|---|---|
| 335' | 2" | 320' |

| Type of Casing | Hole Depth | Depth to Static Water Level |
|---|---|---|
| PVC | 335' | 100' |

TYPE OF COMPLETION: (Circle One or More): Gravel Packed, Underreamed, Telescoped, (Natural Development), Open Hole, Other (Describe) _____

**WELL GROUTED TO A DEPTH OF 20 FEET**
**Type Grout (circle one): Cement, (Bentonite) or Mix**

## SCREEN DATA

| Diameter - Inches | Length - Feet | Slot Size - Inches |
|---|---|---|
| 2" | 15 | .004 |

| Screen Type | Depth to Bottom - Feet |
|---|---|
| PVC Wrapped | 335' |

## LOG DATA

TYPE OF LOG RUN (Circle One): (No Log Run) Electric, Gamma Ray, Density, Sonic, Neutron, Other (Describe) _____

Name of Organization Running Log

## GEOLOGIC DATA (Office Use Only)

| Surface Elev. | Geologic Unit | Unit Thickness | Depth to Top |
|---|---|---|---|
| Subs. SWL | Date | Analysis | Aquifer Test |

Driller's Remarks

Top of Lap Pipe or Reduction in Casing

FEET — IF TELESCOPED OR MORE THAN ONE SCREEN: USE BACK PAGE

| DESCRIPTION OF FORMATIONS ENCOUNTERED | FROM | TO | FORMATIONS (Continued) | FROM | TO |
|---|---|---|---|---|---|
| Top Soil | 0 | 2 | | | |
| Blue Clay | 2 | 20 | | | |
| White Coarse Sand | 20 | 128 | | | |
| Blue Clay | 128 | 315 | | | |
| Med gray Sand | 315 | 335 | | | |
| | | | IF MORE SPACE IS NEEDED, USE BACK | | |

If well telescopes please sketch and show depths.

GROUND LEVEL

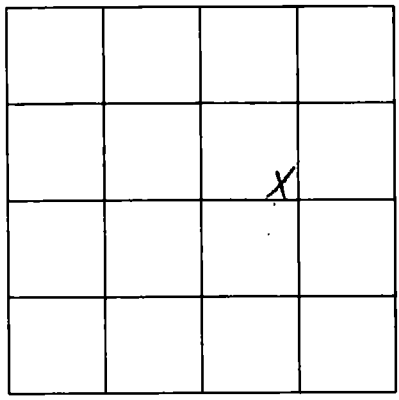


SECTION 1

Please indicate well location X.

ADDITIONAL INFORMATION

If more than one screen, show location of each on sketch.