

JACKSON MISSISSIPPI BOARD OF WATER COMMISSIONERS

067
5-14-62

WATER WELL DRILLERS LOG

Date: May 14, 1962, Driller: L. L. Garland County Jackson
55 (Name)

(1) Owner of Land:	Description & Color of Materials Sand, Clay, Red Clay, Shell, etc.	Thick- ness Feet	Depth Feet
<u>Charcoal Co.</u> (Name) <u>Fountainbleau Mine</u> (Address)	<u>27' Clay 14' Sand</u>		
	<u>17' Sand 4' Mud</u>		
	<u>3' Mixed</u>		
(2) Location: _____ 1/4, _____ 1/4, Sec. <u>30 757</u>	<u>4' 18' Sand 3' Mud</u>		
<u>6</u> miles <u>East</u> of <u>O.S.</u>	<u>5' Mud</u>		
(distance) (direction) (Nearest Town)	<u>6' " & Sand Strips.</u>		
(3) Topography: _____ (Hilly) (Flat) (Level)	<u>7' Sand (Fine)</u>		
(4) Purpose of Well: <u>Industrial</u> (Domestic Irrigation Municipal, Industrial, Other)	<u>8' " "</u>		
	<u>9' 2' Sand 19' Mud</u>		
	<u>10' Mud</u>		
	<u>11' "</u>		
	<u>12' "</u>		
	<u>13' 15' Mud 6' Sand</u>		
	<u>14' 18' Sand 3' Mud</u>		
	<u>15' Mud Mud & Shale</u>		
	<u>16' " "</u>		
	<u>17' Shale & Rock</u>		
	<u>18' Mud & Shale</u>		
	<u>19' " "</u>		
	<u>20' 16' Mud 5' Sand</u>		
	<u>21' Mud & Shale</u>		
	<u>22' " "</u>		
	<u>23' 17' Mud 4' Sand</u>		
	<u>24' Sand</u>		
	<u>25' 2' Mud 19' Sand</u>		


Information upon completion of well:

- (1) Diameter 2 inches.
- (2) Total Depth 525 feet.
- (3) Water Level 7 feet below top of ground.
- (4) Cased to _____, Size _____.
- (5) Screen: Size 08, Length 10.
- (6) Were any formations sealed against pollution?
_____ yes, no.

If YES depth of formation _____

Why _____

Drillers Remarks: _____

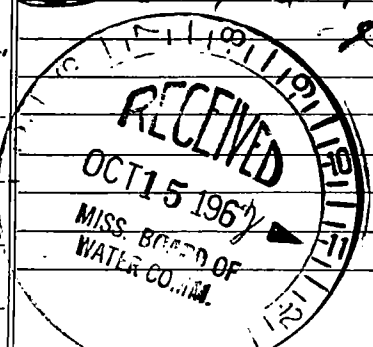

(Use Back Side)

Well No. _____


