Jackson
0108
1-68
JAN.

MISSISSIPPI
BOARD OF WATER COMMISSIONERS
416 North State Street
Jackson, Mississippi 39201

17

WATER WELL DRILLERS LOG

1-4-68 19 COAST WATER WELL SERVICE JACKSON
date well completed — firm name — county well located

LANDOWNER: W. S. Entrekin
VANCLEAVE
(mailing address)

WELL LOCATION:
sec. 5 T 7 N/S R 7 E/W
(distance) miles South of Vanclave
(direction) (nearest town)

WELL PURPOSE: Home
(home, irrigation, municipal, industrial)

WELL COMPLETION DATA:

(1) diameter (inches) 2"
(2) total depth (feet) 173'
(3) static water level (feet) 35' below ~~above~~ top of ground.
(4) casing GALV. (material), 168' (depth), 2" (size) If telescope see back.
(5) screen 5' (length), 168' (depth to top), 2" (size), PLASTIC (material)
(6) pump 1 (HP) 8 (yield gpm) Elect. (type power)
(7) electric log NO (yes or no)
(organization running log)
(8) how well bottom plugged 2" BACK WASH VALVE

DRILLERS REMARKS:

description of formations encountered	from	to
RED CLAY	0	15
FINE SAND	15	25
BLUE CLAY	25	70
MED. SAND	70	100
BLUE CLAY	100	155
MED. SAND.	155	173

JAN 23 1968 MISS. WATER COMM.

If well telescopes please sketch and show depths.

GROUND LEVEL

If more than one screen, show locations of each on sketch.

SE NW

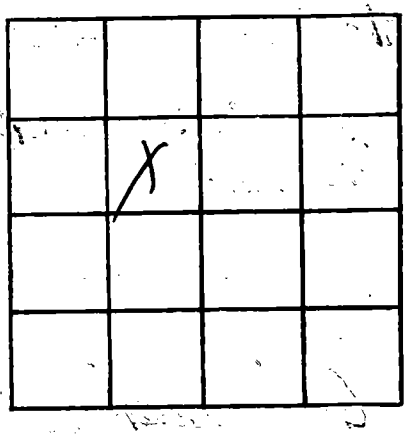

SECTION 5

Please indicate well location X.

ADDITIONAL INFORMATION