JACKSON
Ø224
4-23-73

CODED

MISSISSIPPI
BOARD OF WATER COMMISSIONERS
416 North State Street
Jackson, Mississippi 39201

WATER WELL DRILLERS LOG

COAST WATER WELL SERVICE

4/23 1973 — date well completed
firm name
Jackson — county well located

LANDOWNER: Leonard Bonnie
Rt. 1
Gautier, Miss.
(mailing address)

WELL LOCATION:
sec. 36 T 7 N S R 7 E W
in Gautier
(distance) miles (direction) of (nearest town)

WELL PURPOSE: Home
(home, irrigation, municipal, industrial)

WELL COMPLETION DATA:

(1) diameter (inches) 2"
(2) total depth (feet) 290'
(3) static water level (feet) 29 below ~~above~~ top of ground.
(4) casing PVC (material), 280' (depth), 2" (size) If telescope see back.
(5) screen 10' (length), 280' (depth to top), 2" (size), PVC (material)
(6) pump 1 (HP) 10 (yield gpm) Elec. (type power)
(7) electric log No (yes or no)
(organization running log)
(8) how well bottom plugged Blue Value

DRILLERS REMARKS:

description of formations encountered	from	to
top soil	0	10
Red clay	10	35
coarse sand	35	65
blue clay	65	100
coarse sand	100	115
blue clay	115	140
med. sand	140	180
Blue clay	180	200
Fine to coarse sand & gravel	200	290

CODED

JUN 25 1973
MISS. BOARD OF
WATER COMM.

If well telescopes please sketch and show depths.

GROUND LEVEL

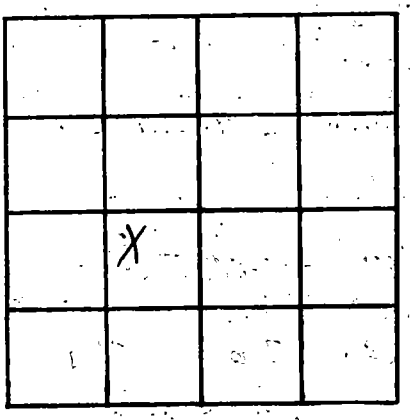

SECTION 36

Please indicate well location X.

ADDITIONAL INFORMATION

If more than one screen, show locations of each on sketch.