JACKSON
Φ244
9-21-73

MISSISSIPPI
BOARD OF WATER COMMISSIONERS
416 North State Street
Jackson, Mississippi 39201

CODED

WATER WELL DRILLERS LOG

9/21 1973 COAST WATER WELL SERVICE Jackson
date well completed — firm name — county well located

LANDOWNER: Edon Ladner
Rt. 2 Box 61-W
Ocean Springs, Miss. 39564
(mailing address)

WELL LOCATION:
sec. 5 T 7 S R 7 W
6 miles NE of Ocean Springs
(distance) (direction) (nearest town)

WELL PURPOSE: home
(home, irrigation, municipal, industrial)

WELL COMPLETION DATA:

(1) diameter (inches) 2"
(2) total depth (feet) 410'
(3) static water level (feet) 43' below above top of ground.
(4) casing P.V.C. (material), 400' (depth), 2" (size) If telescope see back.
(5) screen 10' (length), 400' (depth to top), 2" (size), P.V.C. (material)
(6) pump 1 hp. (HP) 9 g.p.m. (yield gpm) electric (type power)
(7) electric log No (yes or no)
(organization running log)
(8) how well bottom plugged Jackrabbit valve

DRILLERS REMARKS:

description of formations encountered	from	to
Top Soil	0	10
Coarse Sand	10	81
Blue clay	81	83
Fine Sand	83	140
Coarse Sand	140	222
Blue Clay	222	326
Fine Sand	326	347
Coarse Sand	347	410

DEC - 7 1973

If well telescopes please sketch and show depths.

GROUND LEVEL

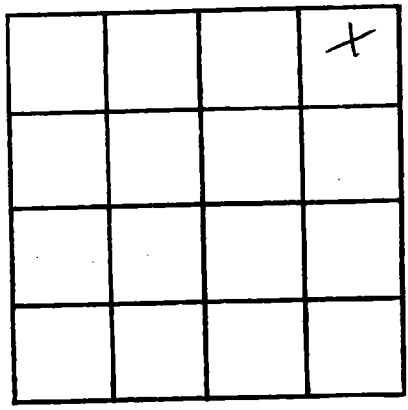

SECTION _____

Please indicate well location X.

ADDITIONAL INFORMATION

If more than one screen, show locations of each on sketch.