JACKSON

0 2085

11-2-78

MISSISSIPPI
BOARD OF WATER COMMISSIONERS
416 North State Street
Jackson, Mississippi 39201

WATER WELL DRILLERS LOG

11-2- 1978 Coast Water Well Serv. Jackson
date well completed — firm name — county well located

LANDOWNER: Church Deaps Christ
6530 Short Cut Rd.
Moss Point Ms.
(mailing address)

WELL LOCATION:
sec. 26 T 7 (S) R 7 (W)
miles in (direction) of Gautier (nearest town)
(distance)

WELL PURPOSE:
(home, irrigation, municipal, industrial)

WELL COMPLETION DATA:
(1) diameter (inches) 2"
(2) total depth (feet) 504'
(3) static water level (feet) 32' below ~~above~~ top of ground.
(4) casing PVC (material), 494 (depth), 2" (size) if telescope see back.
(5) screen 10' (length), 494 (depth to top), 2" (size), PVC (material)
(6) pump 1 (HP) 8 gal. (yield gpm)
Chect- (type power)
(7) electric log No- (yes or no)
— (organization running log)
(8) how well bottom plugged Pick Wash Valve

DRILLERS REMARKS:

description of formations encountered	from	to
Top soil	0	7
Blue Clay	7	30
White Coarse sand + Gravel	30	60
Blue Clay	60	150
Gray Coarse sand	150	260
Blue Clay	260	280
Gray Coarse sand	280	300
Blue Clay	300	453
Gray Coarse sand	453	504 Hole

RECEIVED
NOV - 9 1978
MISS. STATE WATER COMM.

If well telescopes please sketch and show depths.

GROUND LEVEL

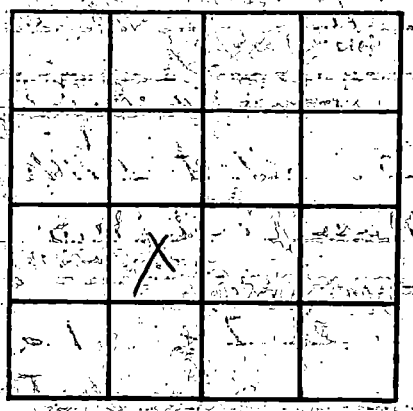

SECTION 26

Please indicate well location X.

ADDITIONAL INFORMATION

If more than one screen, show locations of each on sketch.