Jackson

X 2150

4-23-80

MISSISSIPPI
BOARD OF WATER COMMISSIONERS
416 North State Street
Jackson, Mississippi 39201

WATER WELL DRILLERS LOG

4-23-80 19 Coast Water Well Serv. Inc. Jackson
date well completed — firm name — county well located

LANDOWNER Don Young
3809 Old Spanish Trail
Gautier, Miss 39553
(mailing address)

WELL LOCATION:
sec 34 T 7 N (S) R 7 E (W)
(distance) miles (direction) of (nearest town)

WELL PURPOSE: Home
(home, irrigation, municipal, industrial)

WELL COMPLETION DATA:

(1) diameter (inches) 2"
(2) total depth (feet) 563'
(3) static water level (feet) 40' (below / above) top of ground.
(4) casing PVC (material), 553' (depth),
2" (size) if telescope see back.
(5) screen 10' (length), 553' (depth to top)
2" (size), PVC (material)
(6) pump H.P. (HP) 7½ (yield gpm)
Elect. (type power)
(7) electric log Yes. (yes or no)
(organization running log)
(8) How well bottom plugged Rock Wash Value

DRILLERS REMARKS:

description of formations encountered	from	to
Top soil & red clay	0	10
Blue Clay	10	70
White Coarse sand & gravel	70	90
Blue Clay	90	220
Gray Coarse sand	220	320
Blue Clay	320	478
Gray Coarse sand	478	563
		Hole

DEPT. OF NATURAL RESOURCES
BUREAU OF LAND & WATER RESOURCES
JUL - 2 1980
RECEIVED

If well telescopes please sketch and show depths.

GROUND LEVEL

If more than one screen, show locations of each on sketch.

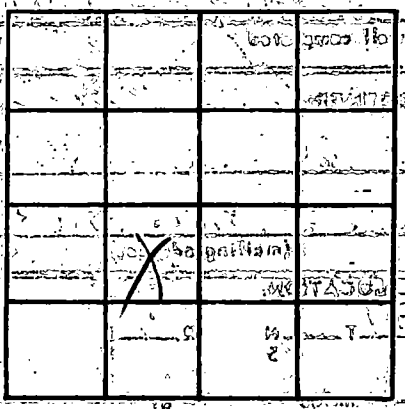

SECTION 34

Please indicate well location X

ADDITIONAL INFORMATION