MISSISSIPPI DEPARTMENT OF NATURAL RESOURCES

Bureau of Land and Water Resources

P.O. Box 10631
Jackson, Mississippi 39209

WATER WELL DRILLERS LOG

COUNTY WELL LOCATED: Jackson	PERMIT NUMBER:
WELL NUMBER: Φ2268 CODED:	NAME OF DRILLING FIRM: Coast Water Well
DATE WELL COMPLETED: 9-8-86	

NAME & MAILING ADDRESS OF LANDOWNER
Evon Williams
6200 Brown Rd
Ocean Springs MS

WELL LOCATION: SEC 29 TOWNSHIP 7 (N) (S) RANGE 7 (E) (W)

DISTANCE 6 Miles DIRECTION W of NEAREST TOWN Ocean Springs

OTHER LANDMARK

WELL PURPOSE: Home, Irrigation, Municipal, Industrial, Fish Pond, etc.
home

PUMP DATA

PUMP TYPE (Circle One): Submersible, Turbine, Jet, Flowing Well, Other (Describe) —

POWER TYPE (Circle One): (Electric) Tractor, Diesel, Gasoline, Butane, Other (Describe)

Pump Capacity (GPM)	No. of Stages	Setting Depth
—	—	— FT.

PUMP TEST

Well yielded — GPM with a drawdown of — ft. after — hours of pumping

WELL DATA

Well Depth	Casing Diameter (In.)	Casing Length (Ft.)
31	2"	26'

Type of Casing	Hole Depth	Depth to Static Water Level
PVC	31'	11'

TYPE OF COMPLETION: (Circle One or More): Gravel Packed, Underreamed, Telescoped, (Natural Development), Open Hole, Other (Describe)

Top of Lap Pipe or Reduction in Casing
FEET — IF TELESCOPED OR MORE THAN ONE SCREEN: USE BACK PAGE

SCREEN DATA

Diameter - Inches	Length - Feet	Slot Size - Inches
2"	5'	.008

Screen Type	Depth to Bottom - Feet
PVC	31'

LOG DATA

TYPE OF LOG RUN (Circle One): (No Log Run), Electric, Gamma Ray, Density, Sonic, Neutron, Other (Describe)

Name of Organization Running Log

GEOLOGIC DATA (Office Use Only)

Surface Elev.	Geologic Unit	Unit Thickness	Depth to Top
Subs. SWL	Date	Analysis	Aquifer Test

Driller's Remarks

RECEIVED
NOV 24 1986
Department of Natural Resources
Bureau of Land & Water Resources

DESCRIPTION OF FORMATIONS ENCOUNTERED	FROM	TO
Top Soil	0	2
Red Clay	2	5
Blue Clay	5	17
Red coarse sand	17	31

FORMATIONS (Continued)	FROM	TO

IF MORE SPACE IS NEEDED, USE BACK

If well telescopes please
sketch and show depths.

GROUND LEVEL

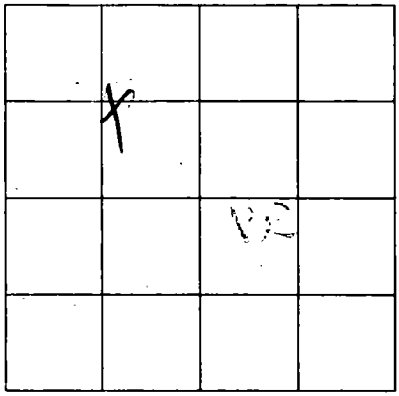

SECTION 39

Please indicate well location X.

ADDITIONAL INFORMATION

If more than one screen,
show location of each on sketch.