loc - pump

MISSISSIPPI DEPARTMENT OF NATURAL RESOURCES

Bureau of Land and Water Resources

P.O. Box 10631
Jackson, Mississippi 39209

WATER WELL DRILLERS LOG

COUNTY WELL LOCATED	Jackson
WELL NUMBER / CODED	Φ 22419
DATE WELL COMPLETED	7-24-87
PERMIT NUMBER	
NAME OF DRILLING FIRM	Coastwater Well Svc.

NAME & MAILING ADDRESS OF LANDOWNER: Josh Gershuny, Po. Box 455, Gautier MS

WELL LOCATION: SEC 13 TOWNSHIP 8 (N/S) RANGE 7 (E/W)

DISTANCE 1N Miles DIRECTION — of NEAREST TOWN GAUTIER

OTHER LANDMARK

WELL PURPOSE: (Home) Irrigation, Municipal, Industrial, Fish Pond, etc.
Lawn Care

PUMP DATA

PUMP TYPE (Circle One): Submersible, Turbine, (Jet) Flowing Well, Other (Describe) ____

POWER TYPE (Circle One): (Electric) Tractor, Diesel, Gasoline, Butane, Other (Describe) ____

Pump Capacity (GPM)	No. of Stages	Setting Depth
16	2	FT.

PUMP TEST

Well yielded ____ GPM with a drawdown of ____ ft. after ____ hours of pumping

WELL DATA

Well Depth	Casing Diameter (In.)	Casing Length (Ft.)
78'	2"	68'

Type of Casing	Hole Depth	Depth to Static Water Level
PVC	78	17'

TYPE OF COMPLETION: (Circle One or More): Gravel Packed, Underreamed, Telescoped, (Natural Development), Open Hole, Other (Describe) ____

Top of Lap Pipe or Reduction in Casing FEET

IF TELESCOPED OR MORE THAN ONE SCREEN: USE BACK PAGE

SCREEN DATA

Diameter - Inches	Length - Feet	Slot Size - Inches
2"	10'	.010

Screen Type	Depth to Bottom - Feet
PVC	78'

LOG DATA

TYPE OF LOG RUN (Circle One): (No Log Run), Electric, Gamma Ray, Density, Sonic, Neutron, Other (Describe) ____

Name of Organization Running Log

GEOLOGIC DATA (Office Use Only)

Surface Elev.	Geologic Unit	Unit Thickness	Depth to Top
Subs. SWL	Date	Analysis	Aquifer Test

Driller's Remarks

DESCRIPTION OF FORMATIONS ENCOUNTERED	FROM	TO	FORMATIONS (Continued)	FROM	TO
Top Soil	0	1			
White Coarse Sand	1	15			
Blue Clay	15	45			
Blue Clay w/ Clamshell's	45	62			
Grey Coarse Sand	62	78			

IF MORE SPACE IS NEEDED, USE BACK

RECEIVED
SEP 21 1987
Department of Natural Resources
Bureau of Land & Water Resources

If well telescopes please
sketch and show depths.

GROUND LEVEL

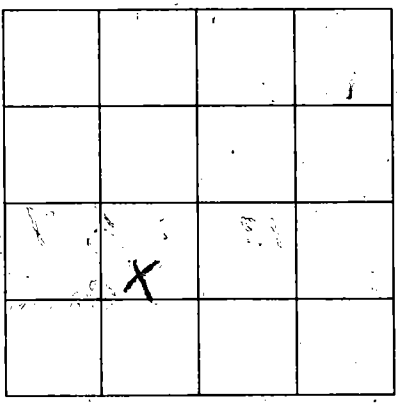

SECTION 13

Please indicate well location X.

ADDITIONAL INFORMATION

If more than one screen,
show location of each on sketch.