MISSISSIPPI DEPARTMENT OF ENVIRONMENTAL QUALITY
Bureau of Land and Water Resources

P. O. Box 10631
Jackson, MS 39289-0631
WATER WELL DRILLERS LOG

COUNTY WELL LOCATED: Jackson	
WELL NUMBER: V-23172	CODED
DATE WELL COMPLETED: 10-4-90	
PERMIT NUMBER	
NAME OF DRILLING FIRM: Coast Water Well Ser Inc.	

NAME & MAILING ADDRESS OF LANDOWNER
Bill French
Rock Hill Rd.
Vancleave, Ms

WELL LOCATION: SEC 4 TOWNSHIP 7 (N) (S) RANGE 7 (E) (W)

DISTANCE 5 Miles **DIRECTION** S of **NEAREST TOWN** Vancleave

OTHER LANDMARK

WELL PURPOSE: Home, Irrigation, Municipal, Industrial, Fish Pond, etc.

PUMP DATA

PUMP TYPE (Circle One): Submersible, Turbine, Jet, Flowing Well, Other (Describe) ____

POWER TYPE (Circle One): Electric, Tractor, Diesel, Gasoline, Butane, Other (Describe) ____ H/P 1

Pump Capacity (GPM)	No. of Stages	Setting Depth
10	2	FT.

PUMP TEST

Well yielded ____ GPM with a drawdown of ____ ft. after ____ hours of pumping

WELL DATA

Well Depth	Casing Diameter (In.)	Casing Length (Ft.)
190'	2"	180'
Type of Casing	**Hole Depth**	**Depth to Static Water Level**
PVC	194'	38'

TYPE OF COMPLETION: (Circle One or More): Gravel Packed, Underreamed, Telescoped, Natural Development, Open Hole, Other (Describe) ____

Top of Lap Pipe or Reduction in Casing FEET

IF TELESCOPED OR MORE THAN ONE SCREEN: USE BACK PAGE

LOG DATA

TYPE OF LOG RUN (Circle One): No Log Run, Electric, Gamma Ray, Density, Sonic, Neutron, Other (Describe) ____

Name of Organization Running Log

GEOLOGIC DATA (Office Use Only)

Surface Elev.	Geologic Unit	Unit Thickness	Depth to Top
Subs. SWL	Date	Analysis	Aquifer Test

Driller's Remarks

SCREEN DATA

Diameter - Inches	Length - Feet	Slot Size - Inches
2"	10'	.008
Screen Type	**Depth to Bottom - Feet**	
PVC	190	

DESCRIPTION OF FORMATIONS ENCOUNTERED	FROM	TO
Top soil	0	2
Yellow Clay	2	20
Gray Clay	20	45
coarse sand	45	80
Blue Clay	80	130
coarse sand	130	190

FORMATIONS CONTINUED	FROM	TO

IF MORE SPACE IS NEEDED, USE BACK

RECEIVED
JAN 11 1991
Dept. of Environmental Quality
Bureau of Land & Water Resources

If well telescopes please sketch and show depths.

GROUND LEVEL

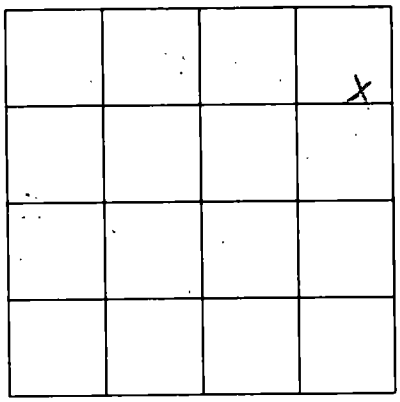

SECTION 4

Please indicate well location X.

ADDITIONAL INFORMATION

If more than one screen, show location of each on sketch.